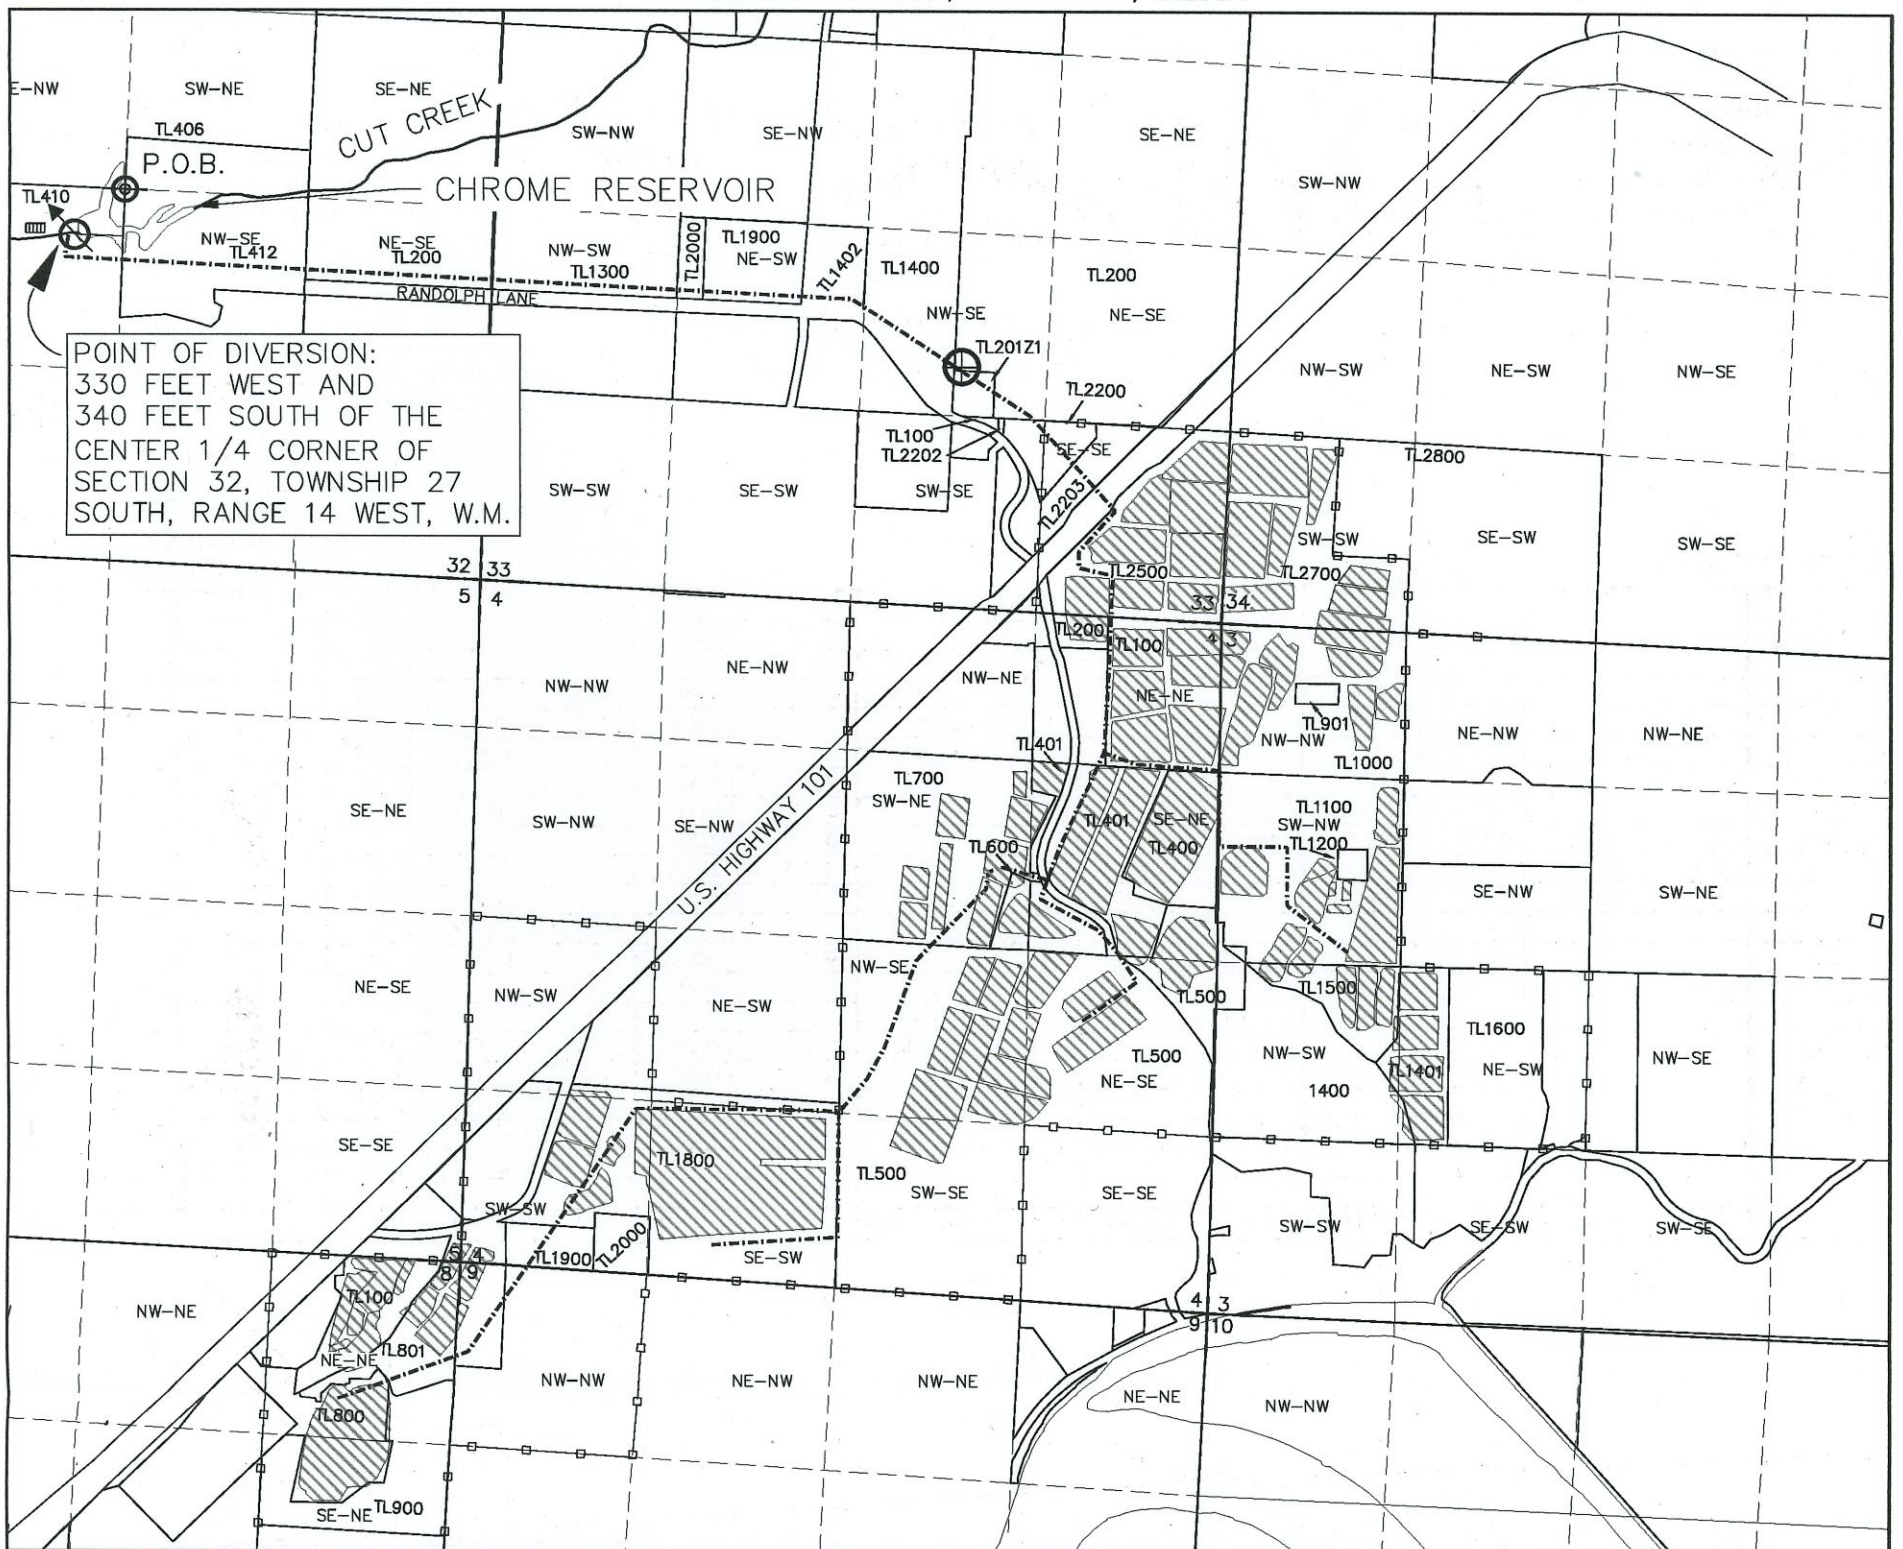


CLAIM OF BENEFICIAL USE MAP

APP. # 72558 PERMIT. # S-53983

LOCATED IN PORTIONS OF SECTIONS 34, 33, & 32 IN TOWNSHIP 27 SOUTH, RANGE 14 WEST
& IN PORTIONS OF SECTIONS 3, 4, 5, 8, & 9 IN TOWNSHIP 28 SOUTH, RANGE 14 WEST
WILLAMETTE MERIDIAN, COOS COUNTY, OREGON

T	R	S	Q	Q	Primary Right	Acres	Primary Right	Acres	Primary Right	Acres	Primary Right	Acres	Primary Right	Acres	Primary Right	Acres	TOTAL
27		33	SE	SE	93417	5.1	39491	15.6									20.7
		34	NE	SW	NO WATER RIGHTS												
		34	SE	SW	NO WATER RIGHTS												
		34	SW	SW	76165	21.2										21.2	
28	14	3 (GL4)	NW	NW	76165	6.2	35933	6.1									12.3
		3	SW	NW	32273	9.9	67077	4.7	86668	0.5							15.1
		3	NE	SW					86668	6.5							6.5
		3	NW	SW			67077	4.3	86668	1.5							5.8
		4	NE	NE	39491	1.6	35933	13.6									15.2
		4	NW	NE	NO WATER RIGHTS												
		4	SE	NE	G12052	1.3	G13433	0.1	29950	1.6	55657	10.5	65884	8	66020	2.5	24.0
		4	SW	NE			G13433	5.2	G13433	4					66020	1.1	10.3
		4	NE	SE			93741	6.36	29950	1.7	37081	1.8	G11045	0.14	66020	0.2	10.2
		4	NW	SE	32420	2.0	93741	7.11	S50974	8.5	37081	0.2	G11045	0.16			17.97
		4	SW	SE			93741	1.88	S50974	1.0							2.88
		4	SE	SW	66869	23.6											23.6
		4	SW	SW	66869	0.4	60575	5.2	65417	0.6							6.2
		8	NE	NE	19530	2.95	89551	1.5	65417	4.7							9.15
		8	SE	NE					65417	4							4.0
		4	NW	SW			60575	0.2									0.2
		9	NW	NW					65417	1.7							
LEGEND																Total	207.0

LEGEND

- DISTRICT BOUNDARY
- MAIN LINE CONVEYANCE
- — — — 1/16TH SECTION LINES
- — — — APPROX. PARCEL BOUNDARY



—POINT OF BEGINNING (P.O.B.)
CENTER 1/4 CORNER OF SECTION 32,
TOWNSHIP 27 SOUTH, RANGE 14
WEST, W.M



—PLACE OF USE (P.O.U.)



—POINT OF DIVERSION (P.O.D.)
AND FISH SCREEN



—TOTALIZING FLOWMETER AND
AUXILLARY PUMP



—FISH LADDER:
(ALL SYMBOLS NOT TO SCALE)

DISCLAIMER: THIS MAP WAS PREPARED FOR THE PURPOSE OF IDENTIFYING
THE LOCATION OF WATER RIGHT ONLY AND IS NOT INTENDED TO PROVIDE
LEGAL DESCRIPTIONS OR LOCATIONS OF PROPERTY LINES.



NORTH
1"=1320'

RECEIVED

MAR 12 2021

OWRD

VCC
VAN CAMP
CONSULTING

P.O. Box 995
Coos Bay, OR 97420
(541) 297-1880
vancampconsulting@gmail.com

Prepared For:
CUT CREEK WATER
IMPROVEMENT DISTRICT
89286 Cranberry Lane
Bandon, OR 97411

Project:
S-53983 CLAIM OF
BENEFICIAL USE

Date:
January 29, 2021