

RECEIVED

SEP 16 2021

OWRD

T.11S., R.29E., W.M.
T.11S., R.30E., W.M.

CLAIM OF BENEFICIAL USE MAP


UNDER

APPLICATION S-88023

PERMIT S-54991

IN NAME OF

ROY VARDANEGA

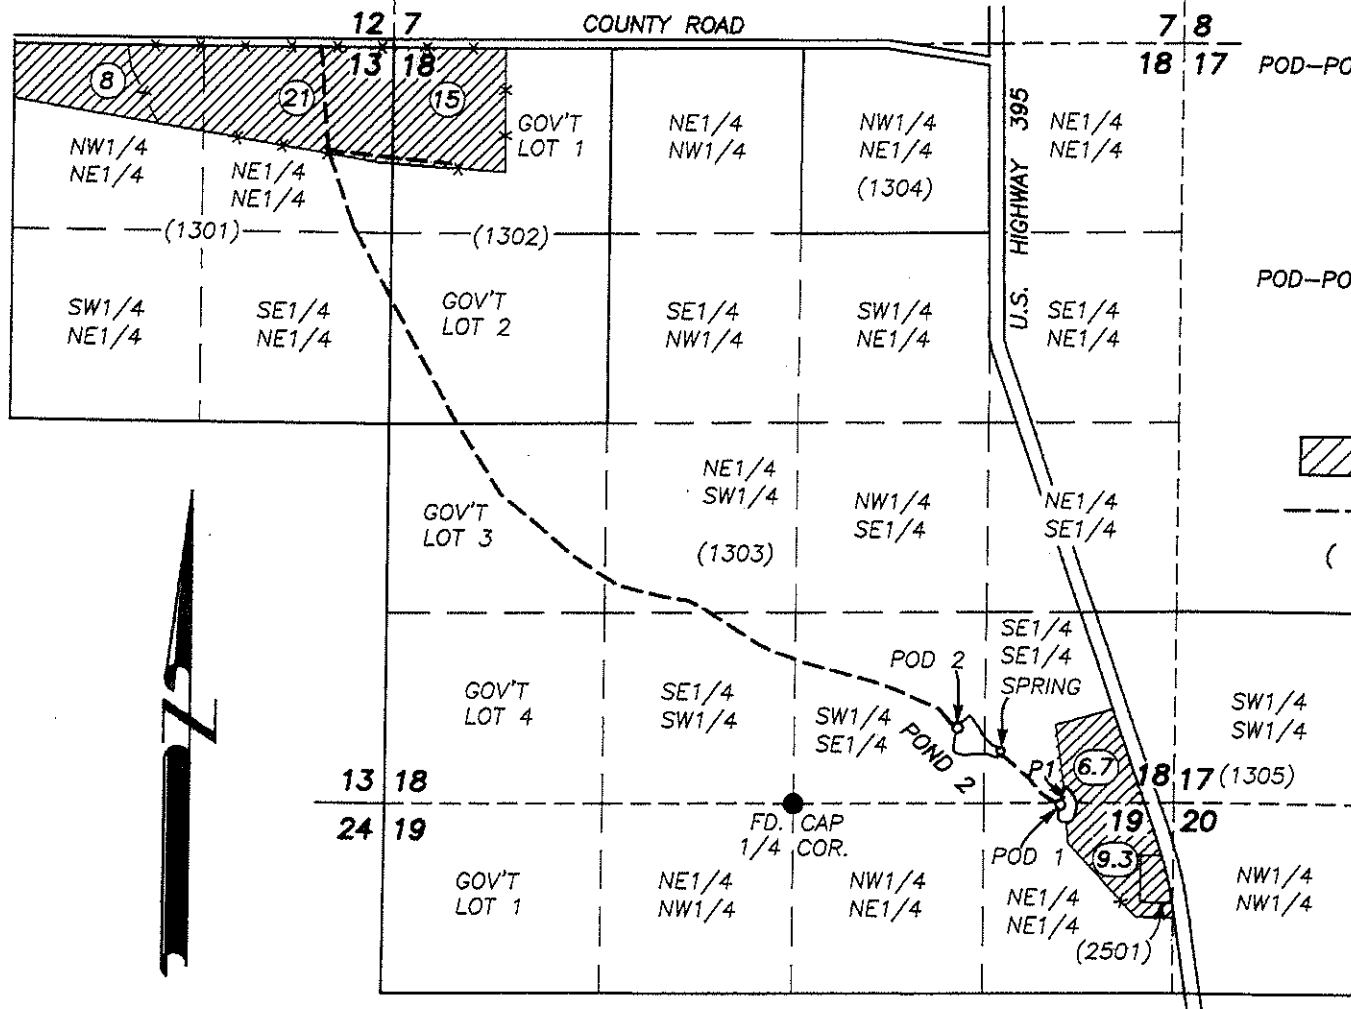

POD-POND 1: CENTERLINE OF DAM AT OUTLET PIPE IS 20 FT. NORTH & 1855 FT. EAST FROM THE S1/4 CORNER SECTION 18.

PUMP AND FLOWMETER BEAR S.10°W., 90 FT. FROM CENTERLINE OF DAM AT OUTLET PIPE.

POD-POND 2: CENTERLINE OF DAM AT OUTLET PIPE IS 540 FT. NORTH & 1130 FT. EAST FROM THE S1/4 CORNER SECTION 18.

BUBBLER BEARS N.60°W., 23 FT. FROM CENTERLINE OF DAM AT OUTLET PIPE.



PLACE OF USE



PIPELINE




TAX LOT

PREPARED BY
ROBERT D. BAGETT, PLS, CWRE
217 N. CANYON BLVD.
JOHN DAY, OR 97845

MAY 22, 2021

SCALE: 1"=1320'

DISCLAIMER: THIS MAP IS NOT INTENDED TO PROVIDE LEGAL DIMENSIONS OR LOCATIONS OF PROPERTY OWNERSHIP LINES.

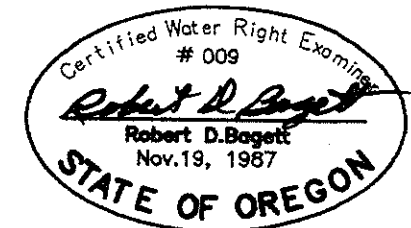

RENEWS 12/31/2021