


T.3S. R.3W. Sec. 19 & 30 T.3S. R.4W. Section 24 & 25, W.M.

RECEIVED
JUL 31 2020

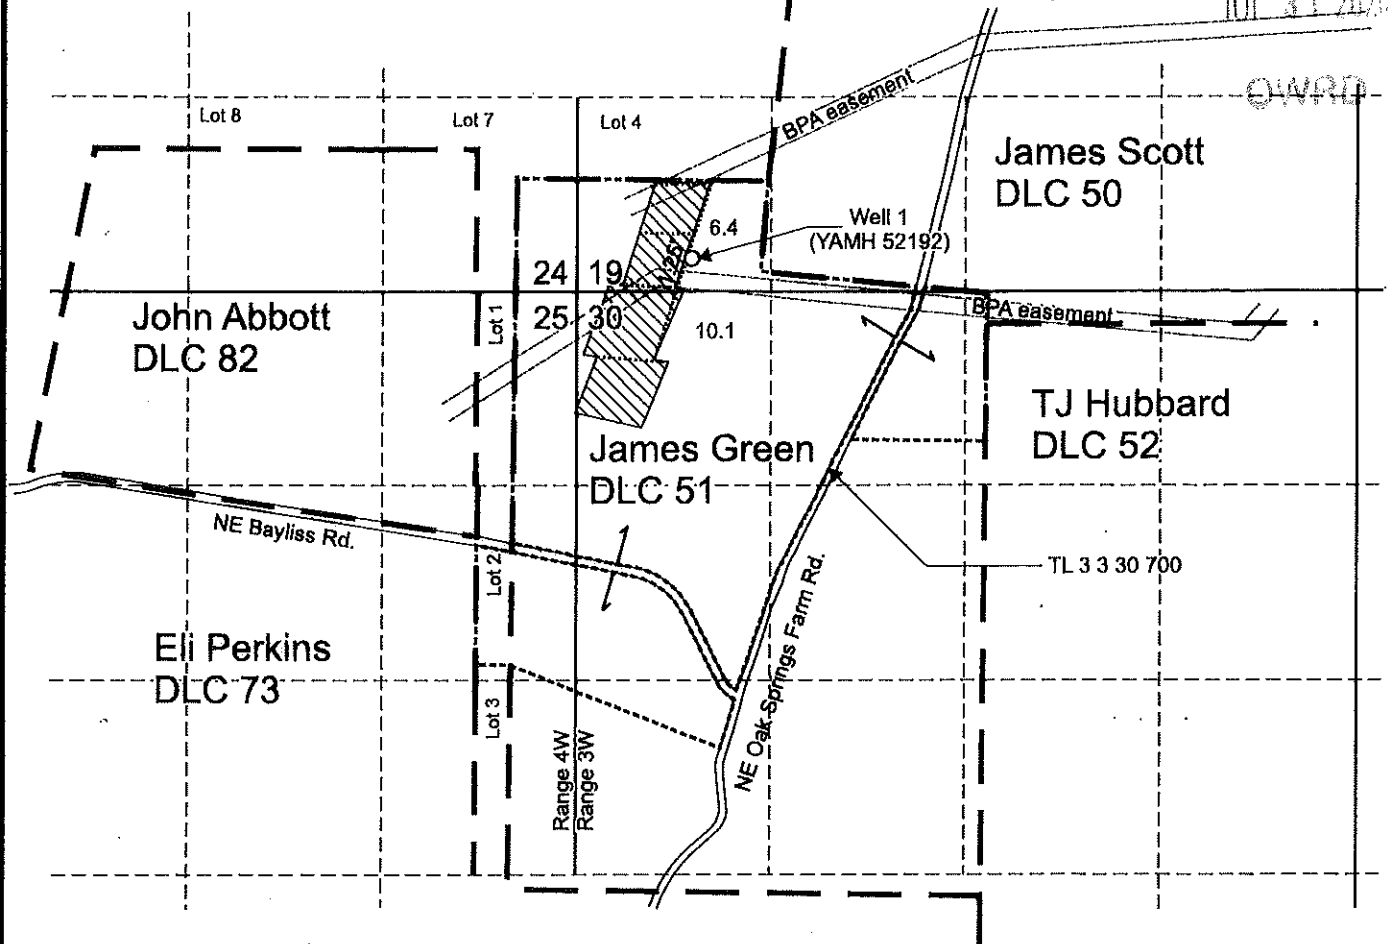

Well 1 (YAMH 52192) is located 220 feet north and 780 feet east from the SW corner, Section 19.

Area (16.5 Acres) irrigated under Application G-15622, Permit G-15248.

----- Tax lot boundary


— — — — — Donation Land Claim boundary

..... Water main line



June 30, 2021

Scale: 1" = 1,320'

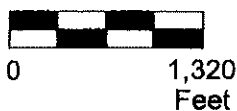

This map was prepared for the purpose of identifying the location of a water right only and is not intended to provide legal dimensions or location of property ownership lines.



Pacific Hydro-Geology Inc.

Claim of Beneficial Use Map
Application G-15622, Permit G-15248
Michael & Drenda Bayliss
T.3S. R.3W. Sec. 19 & 30,
T.3S. R.4W. Sec. 24 & 25, W.M.

07/2020