


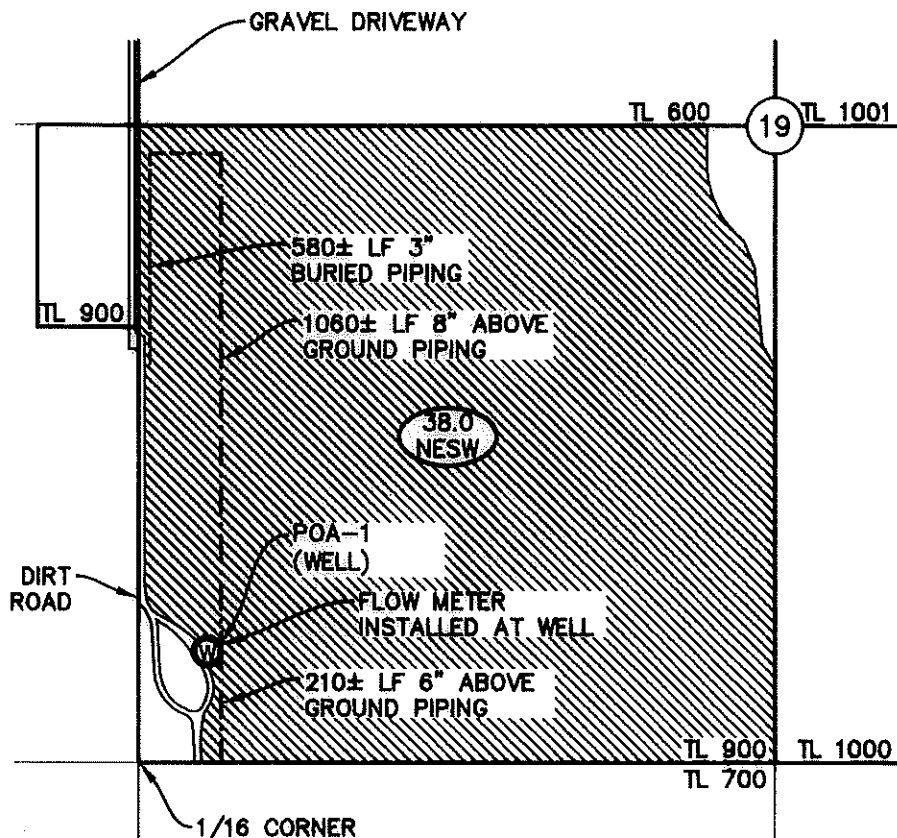

LEGEND

———	1/16TH LINE
-----	BURIED PIPING
- . - . - .	ABOVE GROUND PIPING
=====	TAX LOT LINE
TL 0000	TAX LOT
=====	ROAD
(19)	SECTION CENTER
(W)	POA (WELL)
	IRRIGATED ACRES
(38.0 NESW)	IRRIGATED ACRES
(38.0 NESW)	1/4 1/4 SECTION




WELL TIE

POA WELL: 1050 FEET SOUTH & 1130 FEET WEST FROM THE CENTER 1/4 CORNER OF SECTIONS 19.

NOTES

1. THIS MAP WAS PREPARED FROM FIELD MEASUREMENTS, KLAMATH COUNTY TAX MAP T40S R10E SEC. 19, WM, AND 2005 NAIP AERIAL PHOTO.
2. FOR TAX LOT INFORMATION, SEE TAX MAPS INCLUDED WITH THIS COBU.
3. DATE OF PRIORITY FOR THIS PERMIT IS AUGUST 17, 2001.
4. THIS MAP IS FOR THE PURPOSE OF IDENTIFYING THE LOCATION OF THE WATER RIGHT ONLY AND HAS NO INTENT TO PROVIDE DIMENSIONS OR LOCATION OF PROPERTY LINES.

APPLICANT

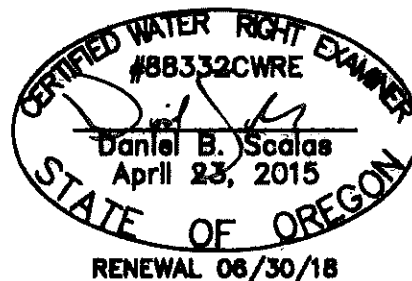

ADKINS

CONSULTING
ENGINEERING, LLP

Engineers ▲ Planners ▲ Surveyors

2950 Shasta Way · Klamath Falls, Oregon 97603 · (541) 884-4666 · FAX (541) 884-5335
Oregon · California

9/22/14

3227-01

CLAIM OF BENEFICIAL USE AND FINAL PROOF MAP

FOR MICHAEL ZALUNARDO AND
RAYMOND ZALUNARDO
T40S, R10E, SEC. 19, WM
KLAMATH COUNTY, OREGON
APPLICATION No. G-15589
PERMIT No. G-15076