


RECEIVED

FEB 09 2022

OWRD

Transfer T-13726 - POD Whitehead - Certificate 21991

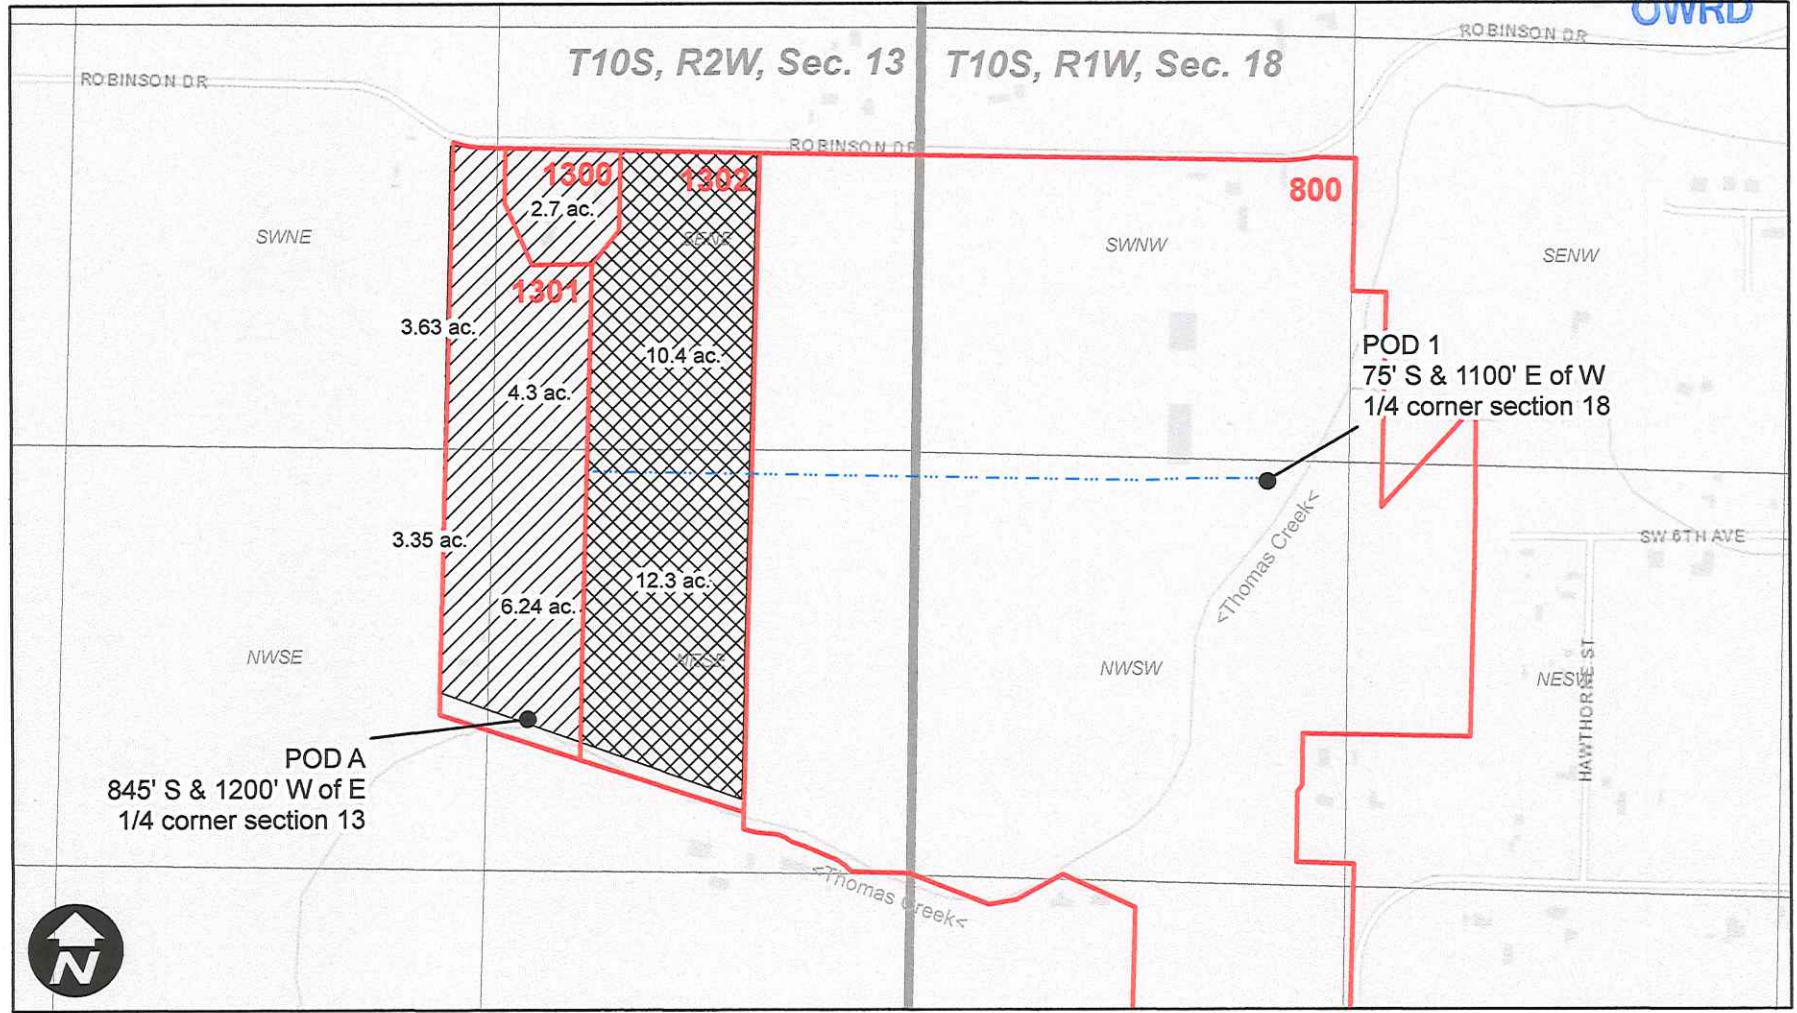

Legend

- Cert. 21991 No Change
- Cert. 21991 Transfer
- Mainline
- Tax Lots