

COLUMBIA RIVER

T. 4N., R. 25E., W. M.

Div. Pt. C.I.D.

MAIN PUMP C.I.D.

NW 1/4 NE 1/4

NE 1/4 NE 1/4

Scale 1" = 400'

DIRT ROAD

T. 5N.

T. 4N.


35

FC.

2

T. 2N., R. 26E., W. M.

B.C.

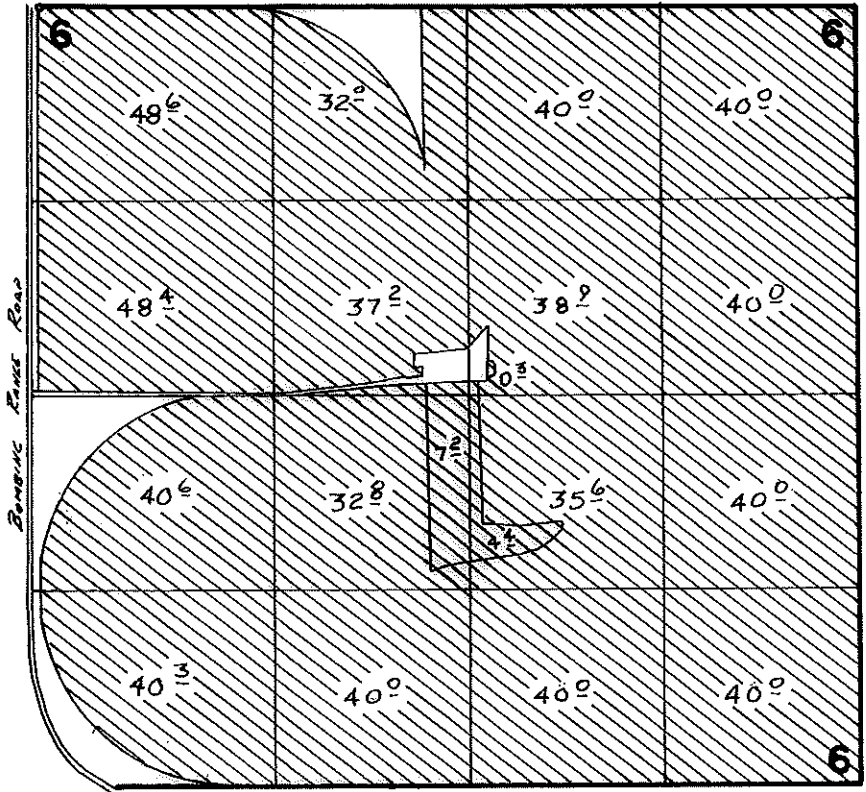

Div. Pt. C.I.D. Loc: 150' S. and  
 2995' W. From NE Cor.  
 Sec. 2

### FINAL PROOF SURVEY

UNDER

Application No. **58329** Permit No. **44153**.....  
 IN NAME OF

.....**JERALD E. REA**.....

Surveyed **11-15**..... **1983**, by **R. L. Church**.....