


Claim of Beneficial Use MAP under Permit S-54507
T 37 S, R 5 W, W M, Portion of Section 20, Josephine County
November 27, 2019

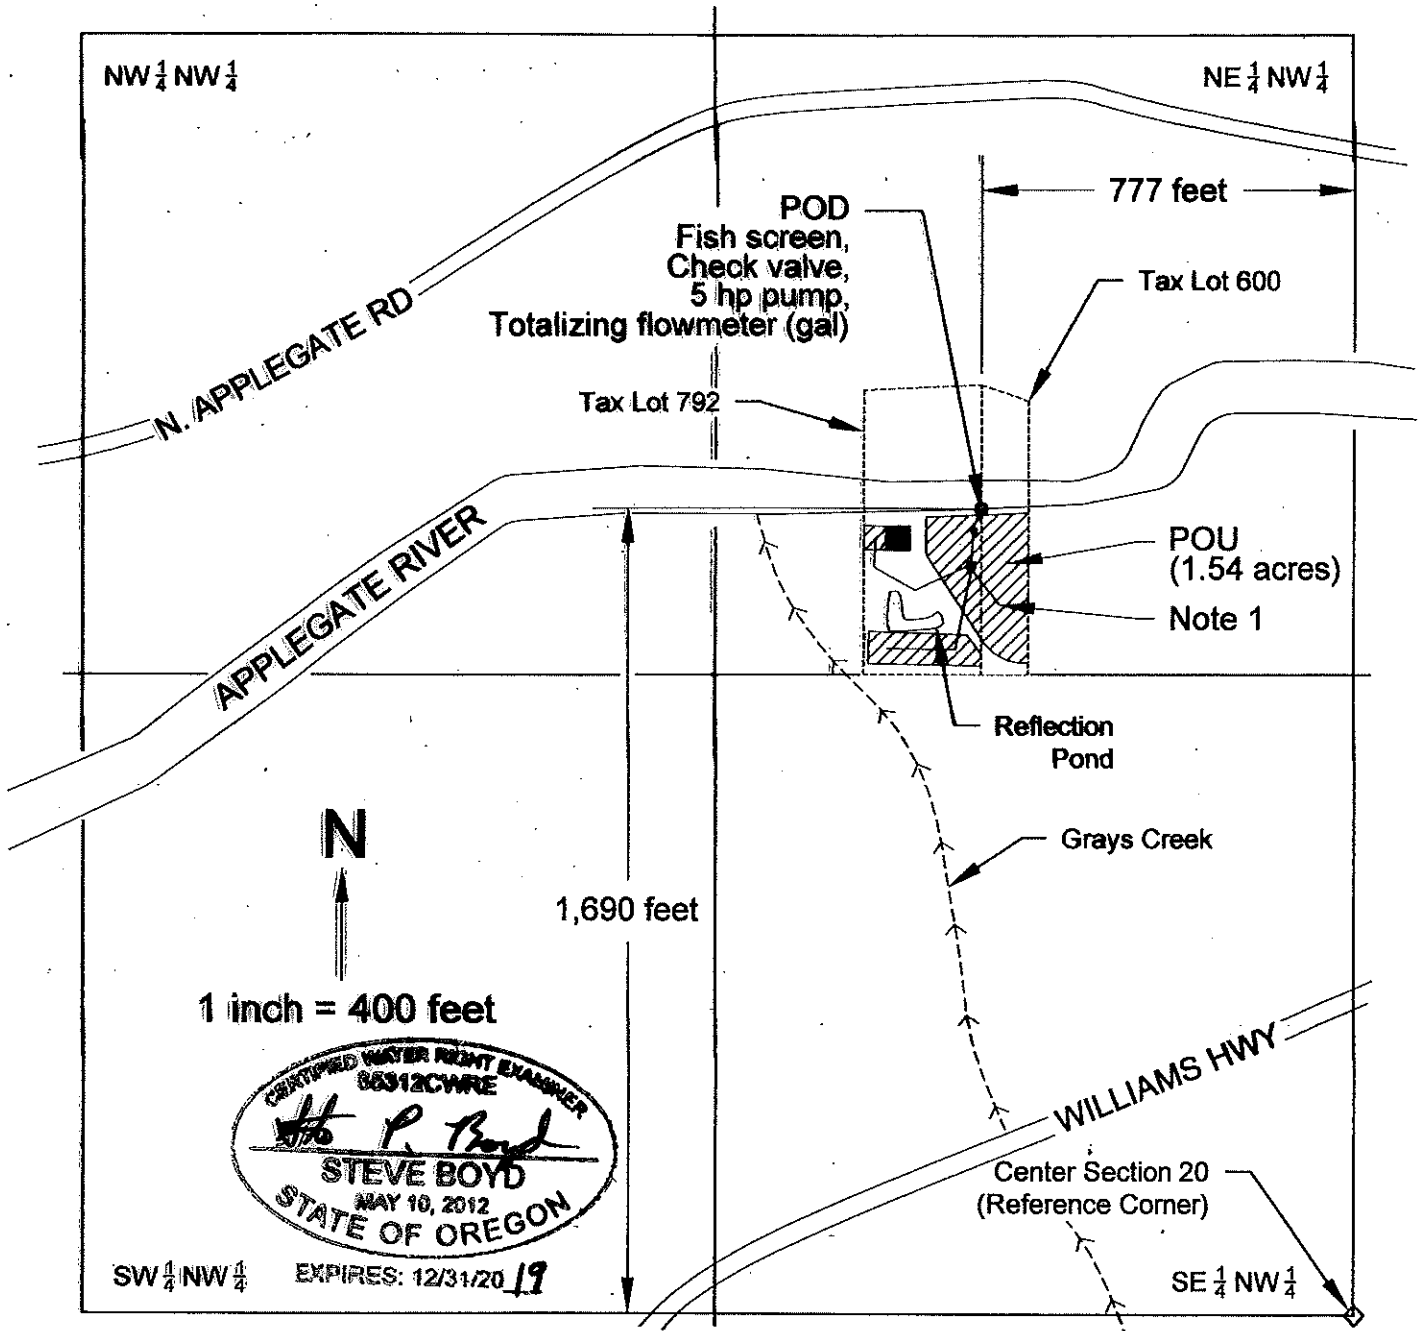

POU (Place of Use) - Total of 1.54 acres irrigated under Application File No. S-87163 and Permit S-54507 with Date of Priority May 5, 2008.

POD

Point of Diversion is 1,690 feet N and 777 feet W of the Center of Section 20.



Structures

Note 1

2.0 inch dia. buried PVC pipes supplying sprinklers, drip lines, hand lines for irrigation of lawn, vegetables, medical marijuana, fruit trees, etc.

This map was drawn by Steven P. Boyd (CWRE #85312) for ABUNDANS L.L.C. (owner of Tax Lots 600 & 792) in support of Claim of Beneficial Use for irrigation.

NOTE: This map is not intended to provide legal dimensions or locations of property ownership lines.