


Wheeler County, Oregon  
T10S, R20E, W.M.

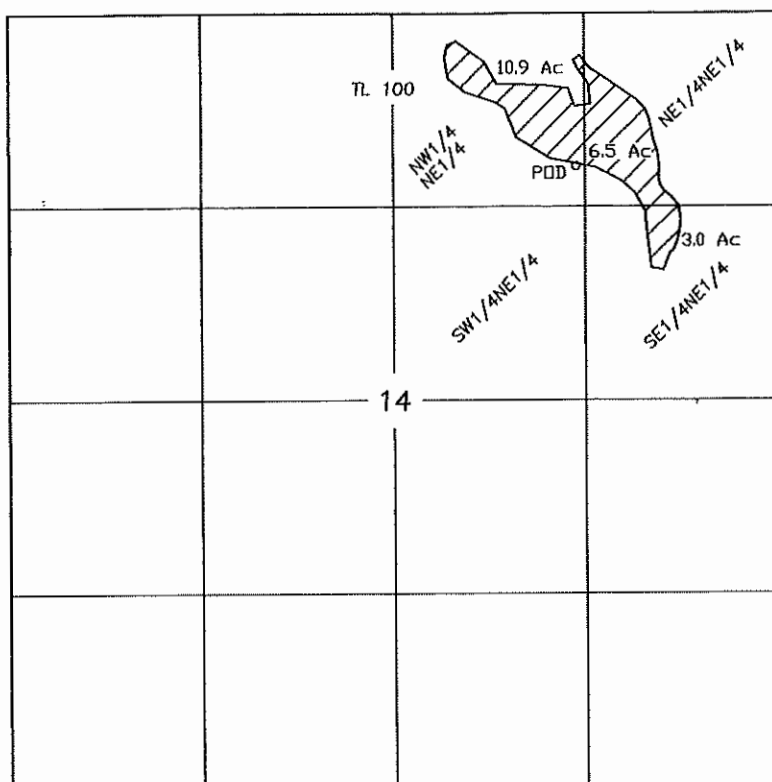

RECEIVED  
AUG 07 2023  
OWRD

SCALE 1"=1320'


POD is located 1020' South & 1370' <sup>West</sup> ~~East~~ of the  
NE corner of Section 14.

Measuring device is located 30' South of the outlet

CLAIM OF BENEFICIAL USE  
ADDITIONAL POD  
T-9871

June 10, 2022

LEGEND

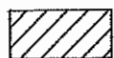

T-9871  
Priority 1882

A portion of Tax Lot  
10-20 TL100

NOTE: Tax Lot 100 is owned by the BLM  
and is more that 16,000 acres.  
Therefore only a portion of the tax  
lot can be shown.

NOTE: The preparation of this map  
was for the purpose of identifying  
the location of the proposed water  
right and has no intent to provide  
dimensions or location of property  
ownership lines.

For  
Bureau of Land Management  
28910 Hwy 20 W  
Hines, OR 97738

