


T. 26S., R. 3W., W.M.

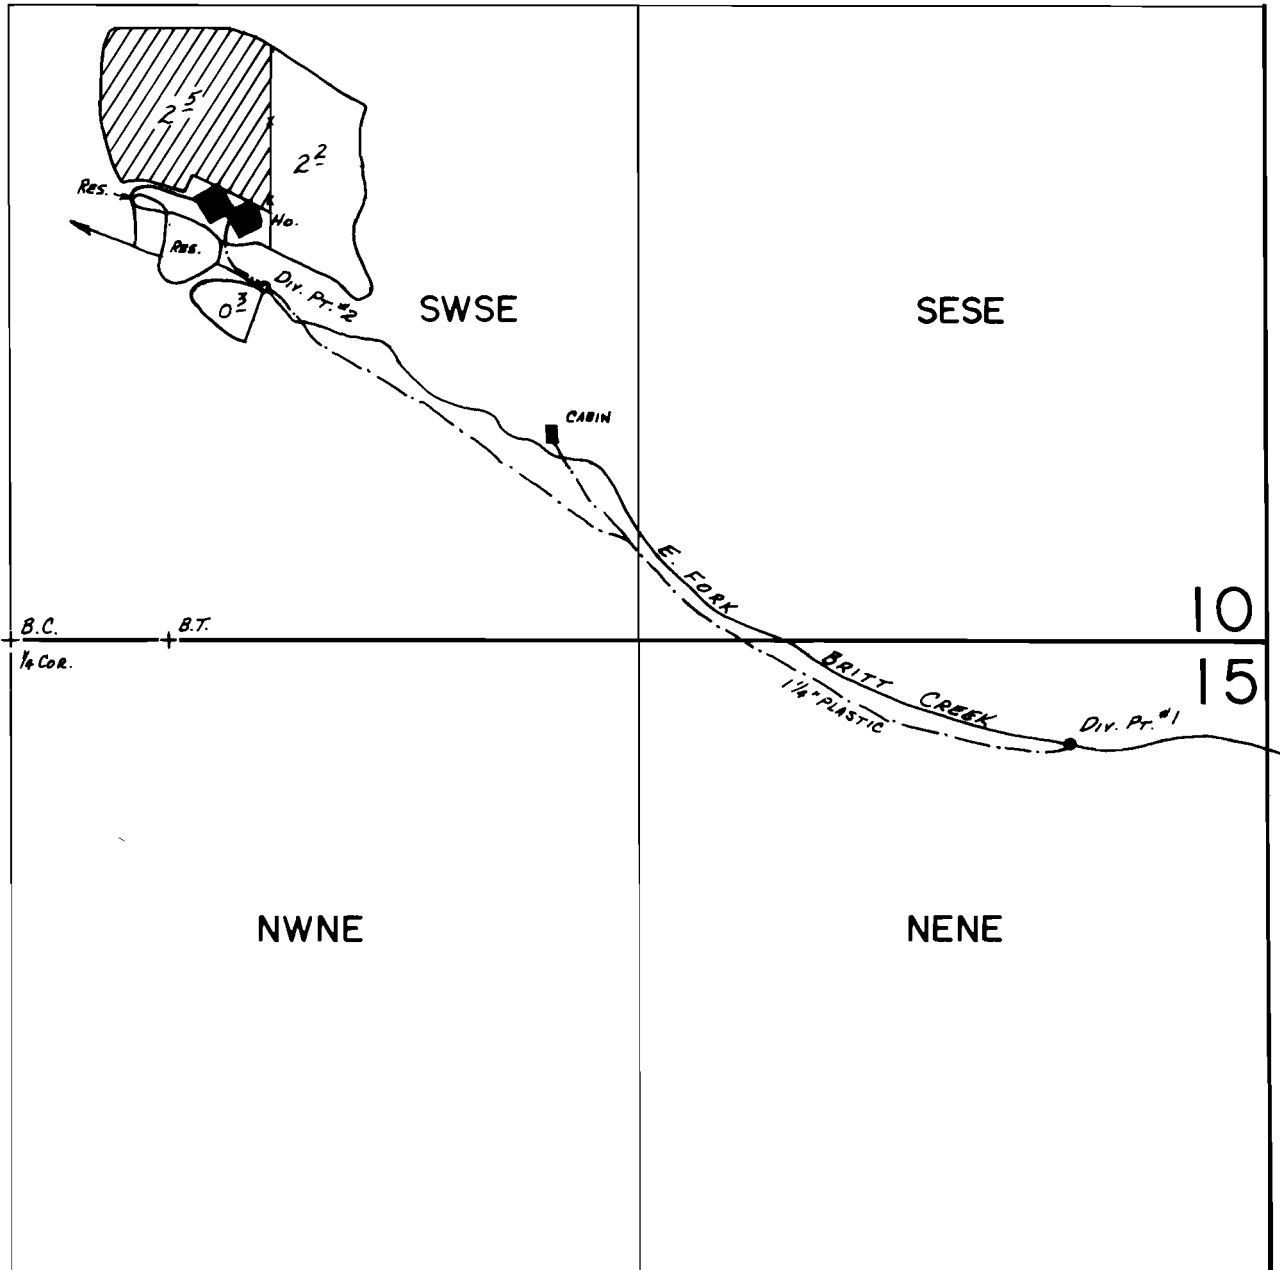

DIV. PTS. LOC.: #1- 210 S. & 2200 E.; #2- 730 N. & 530 E., BOTH FROM S. 1/4 COR. SEC. 10.

SCALE: 1" = 400'

FINAL PROOF SURVEY

UNDER

Application No. 45508... Permit No. 33736.....

IN NAME OF

ALAN B. KNUDTSON

Surveyed APR. 17, 1980, by J.S. DONALDSON

APPLICATION FOR TRANSFER

ADDITIONAL POINT OF DIVERSION

CERTIFICATE 52186


TOWNSHIP 26 S., RANGE 3 W., W.M.

DOUGLAS COUNTY, OREGON

RECEIVED

JUN 24 2021

OWRD

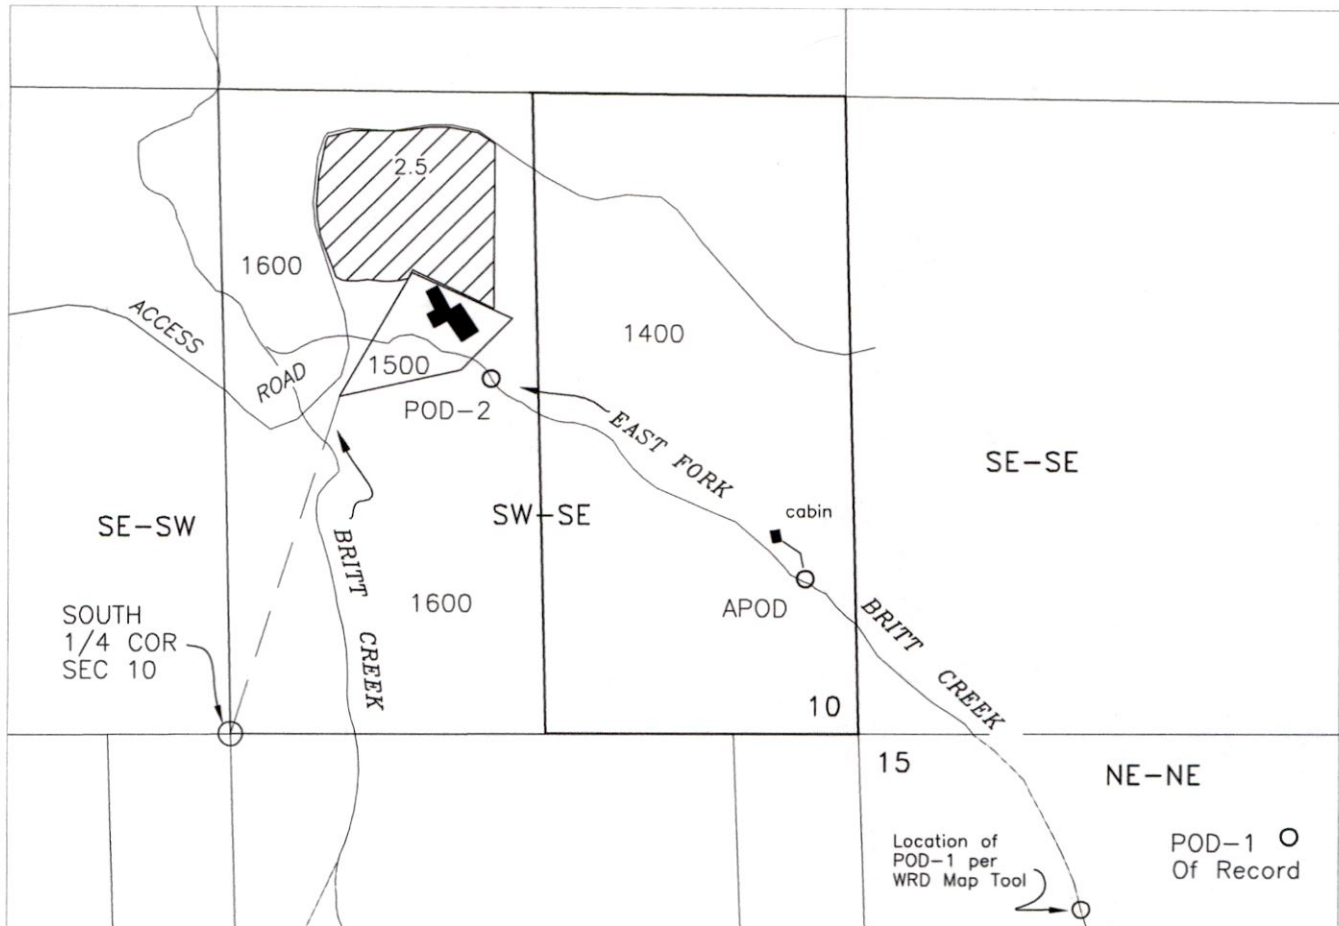

Legend

POD-1 (Record) NE/NE Section 15, 210 feet South & 2200 feet East from the South 1/4 Corner Section 10
 POD-2 (Record) SW/SE, Section 10, 730 feet North & 530 feet East from the South 1/4 Corner Section 10
 APOD - SW/SE, Section 10, 315 feet North & 1200 feet East from the South 1/4 Corner Section 10


TL-1400 (cabin) Domestic Use - POD-1 & APOD after transfer

Remaining Right - TL-1500, 1600 Domestic use and Irrigation of 2.5 acres - POD-1, POD-2

NARALTO, LLC
 P.O. BOX 1001
 ROSEBURG, OR 97470

Scale
 1" = 400'

NORTH

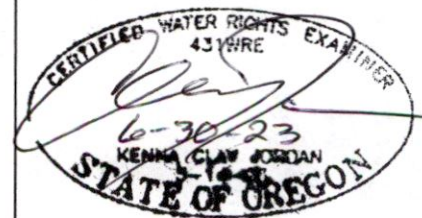

JORDAN ENGINEERING

460 JORDAN LANE
 ROSEBURG, OREGON 97471
 (503) 877-1931

13755

5/11/2021 n.e.d.

Base Map: Douglas County GIS mapping adjusted to and oriented to survey map M-116-51 & M37-1 over 5/10/2019 Google aerial photo & Oregon Map aerial photo for assumed best fit

This map is not intended to provide legal dimensions or locations of property ownership lines