


Transfer Application T-10225

Claim of Beneficial Use - Aebi

RECEIVED
MAY 08 2020
OWRD

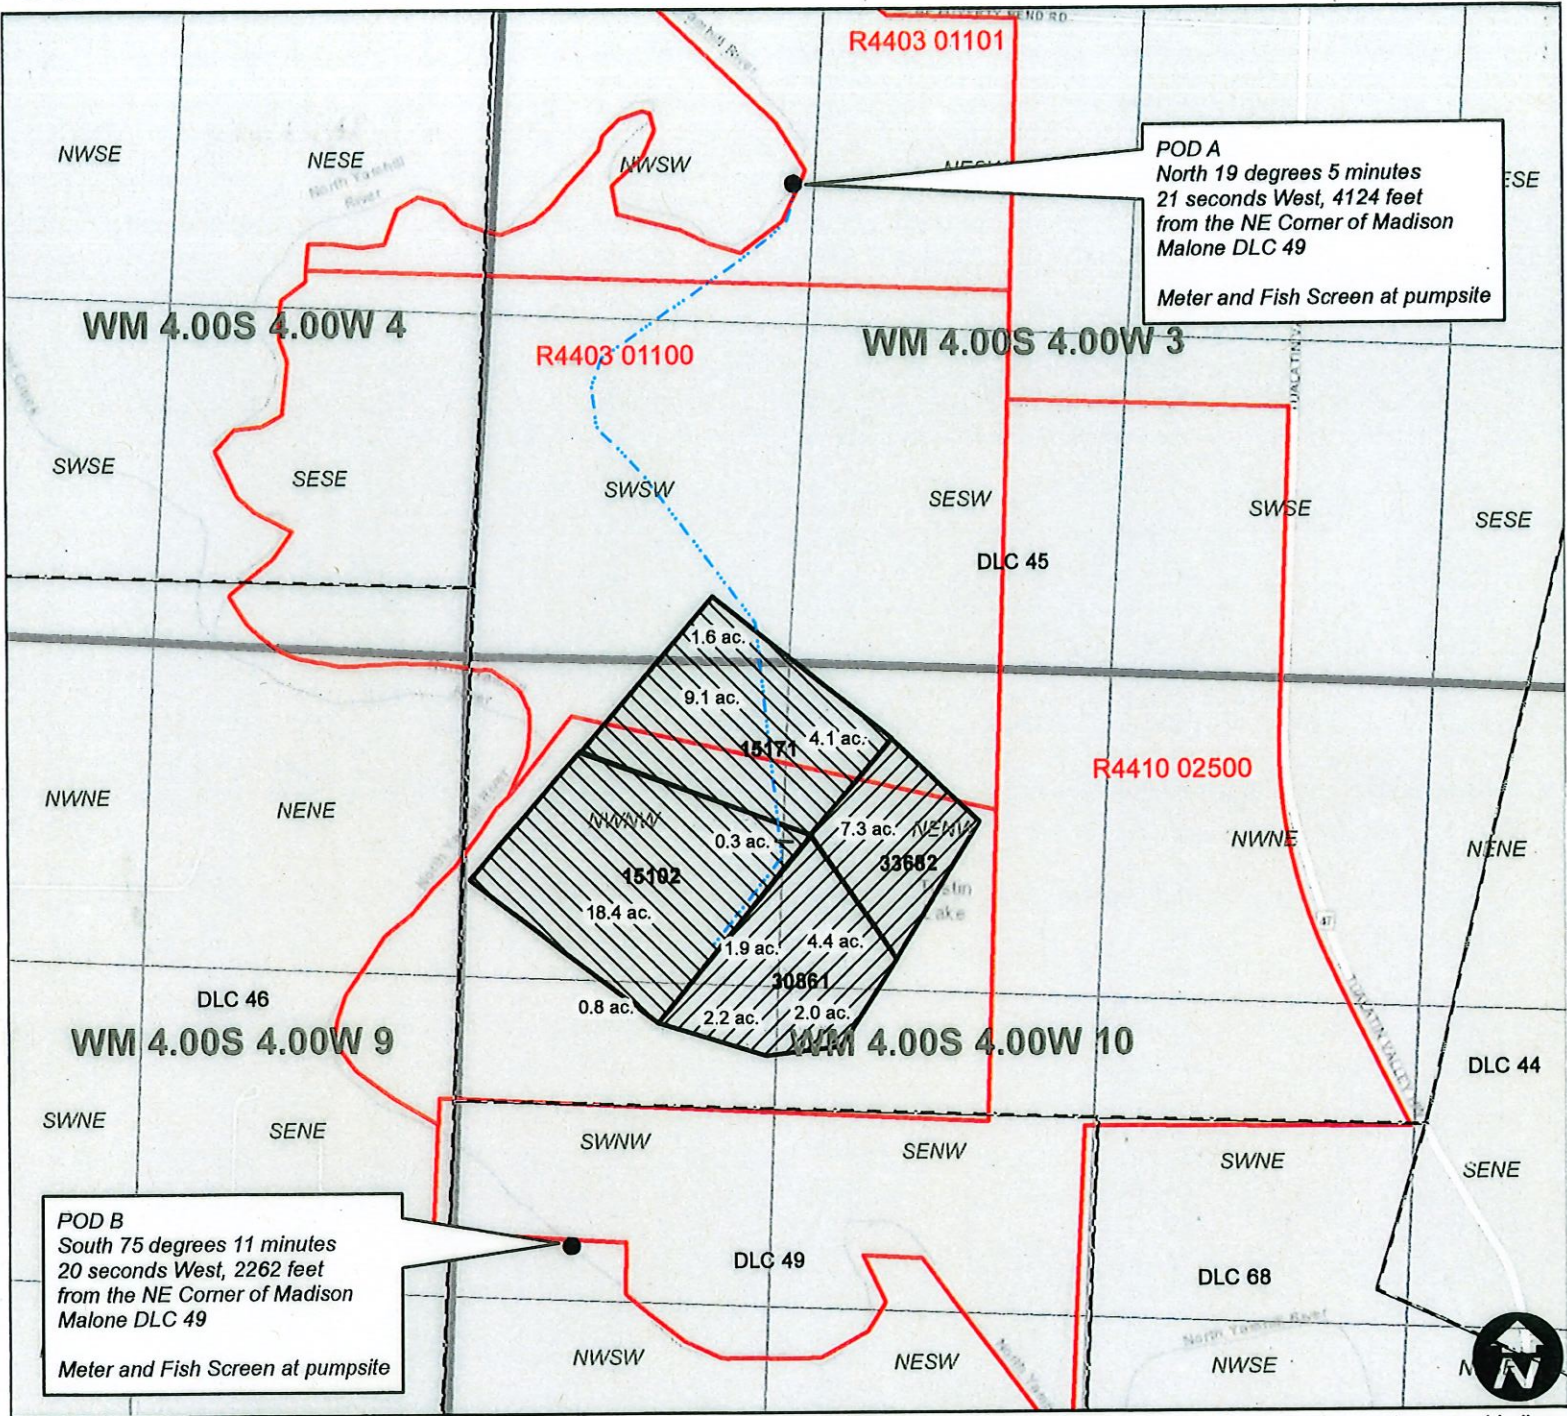

0 400 800 1,600 Feet

This map is not intended to provide legal dimensions or locations of property ownership lines.

Legend

- POU from POD A
- Tax Lots
- POU from POD B
- DLC
- Buried Mainline



EXPIRES: 12/31/2020