


T33S R29E, WM
HARNEY COUNTY, OREGON

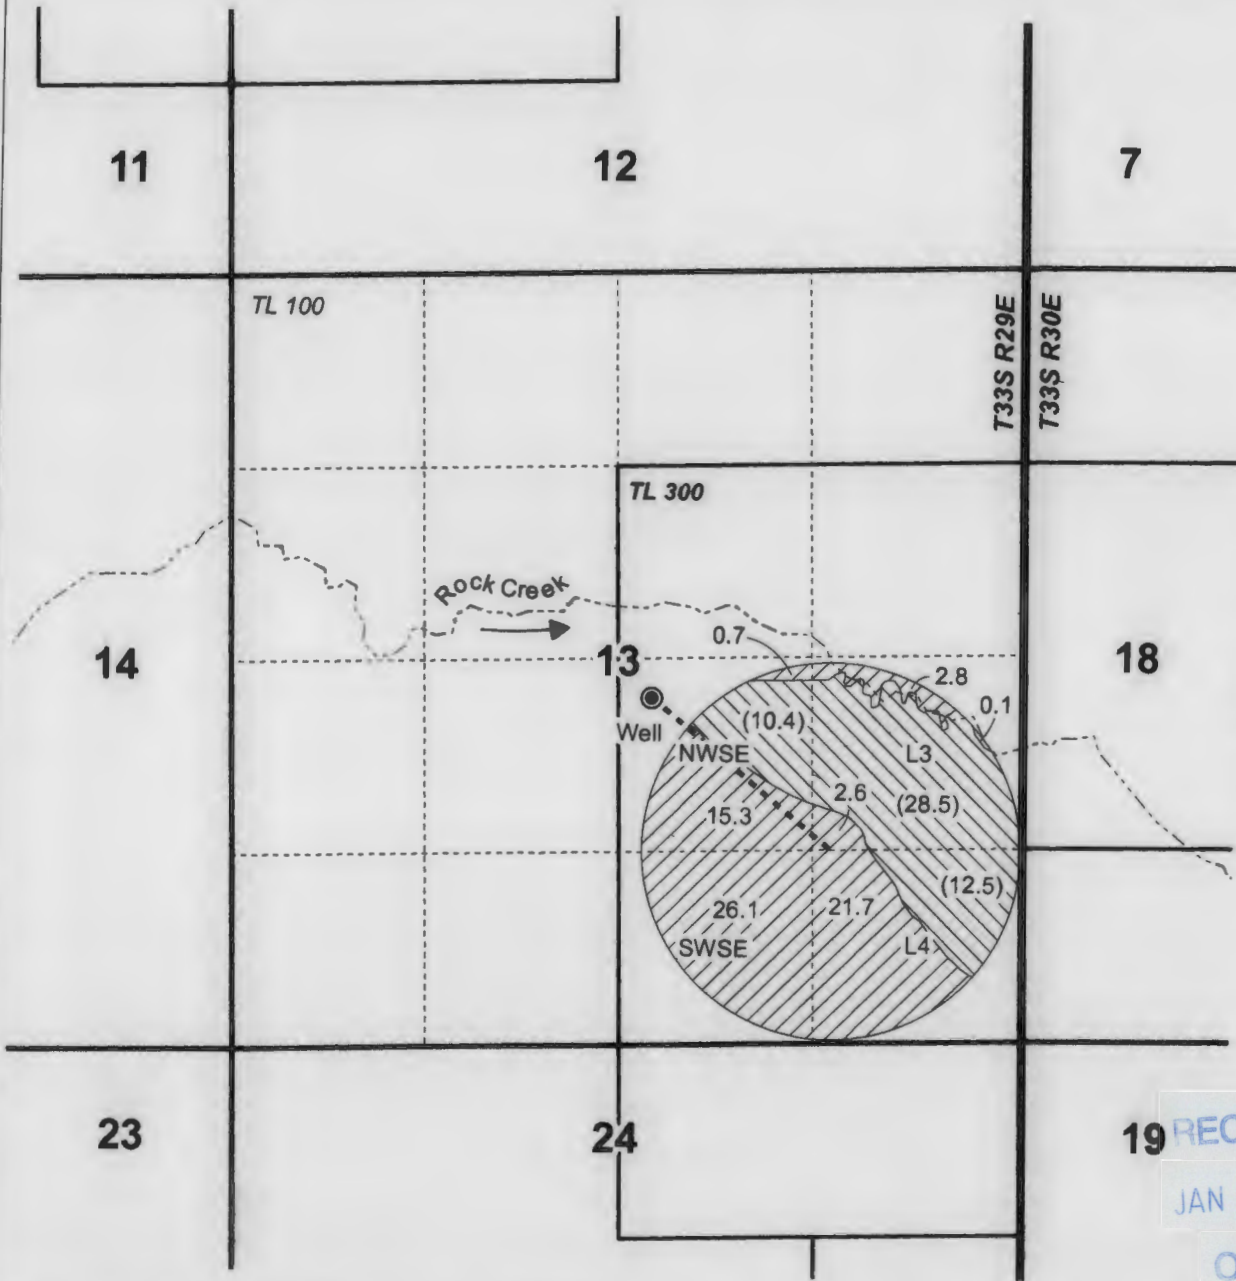


0 660 1,320
 Feet

1 inch = 1,320 feet

- Well & Meter
- Pipeline
- - - - - Creek
- POU IR 69.3 AC
- POU (IR) 51.4 AC (TO MAKE UP A DEFICIENCY IN RATE)
- Township
- Section
- Tax Lot
- - - - - Quarter Quarter

Well (HARN 52053 / L-113537) Location:
 260' S 220' E of Cen Cor S 13

19 RECEIVED
 JAN 02 2024
 OWRD

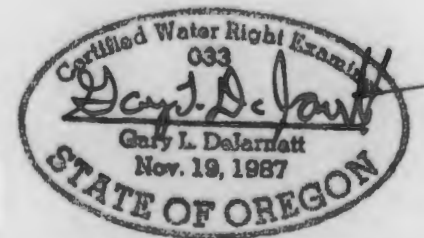

RENEWAL DATE 12/31/2023



CLAIM OF BENEFICIAL USE MAP
Rock Creek Ranch, Inc.

NOTE: THIS MAP IS NOT INTENDED TO
 PROVIDE LEGAL DIMENSIONS OR LOCATIONS
 OF PROPERTY OWNERSHIP LINES.

WATER RIGHT SERVICES, LLC
 PO BOX 1830, BEND, OR 97709
 CCB# 197121 www.oregonwater.us
 541-389-2837 JOHNSHORT@USA.COM

Date: 9/29/2023 AP G-18665 / PERMIT G-18721

PROJECT #23050