


Claim of Beneficial Use Transfer T-13348

A Water Right held by T&K Sester Family, LLC
Clackamas County, Oregon
Township 2 South, Range 3 East (W.M.)

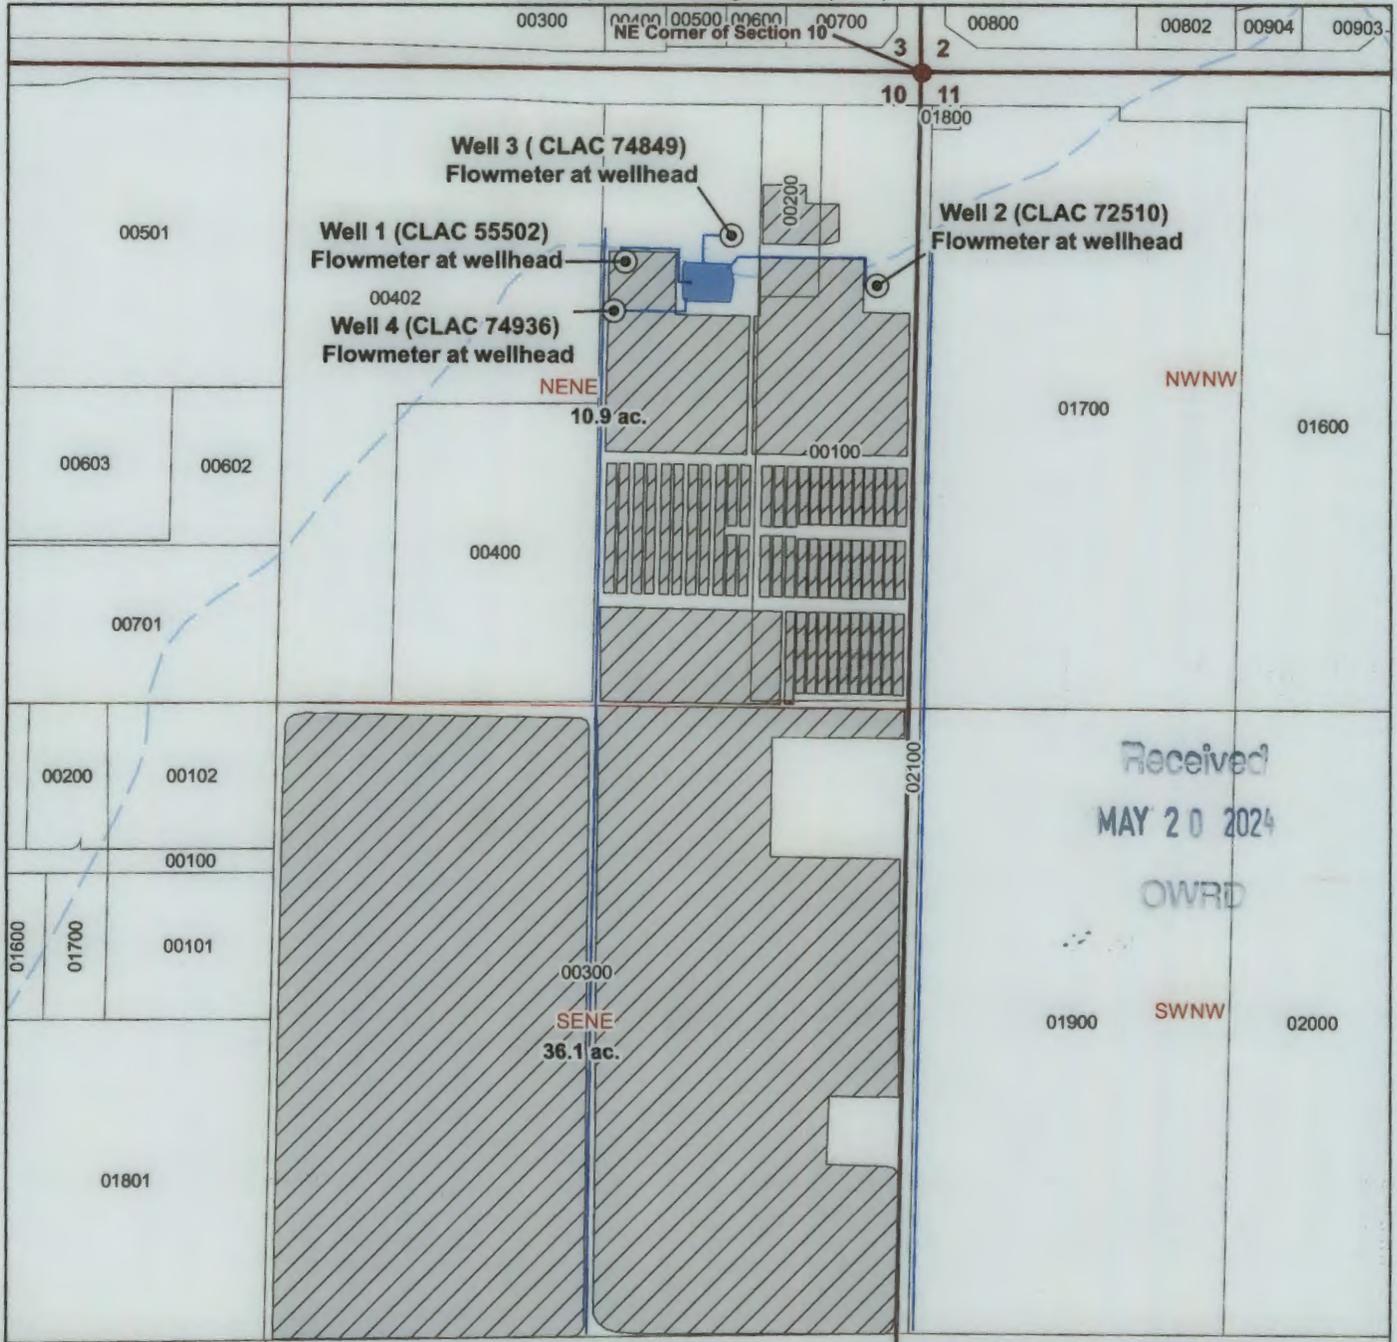

Received
MAY 20 2024
OWRD

LEGEND

- Point of Appropriation (POA)
- Place of Use (POU)
- Property Lines
- Bulge
- Streams
- Mainline


POA Location Descriptions

Well 1 (CLAC 55502/55576):
Located 400 feet South and 613 feet West from the NE corner of Section 10, Township 2 South, Range 3 East (W.M.)


Well 2 (CLAC 72510):
Located 448 feet South and 87 feet West from the NE corner of Section 10, Township 2 South, Range 3 East (W.M.)

Well 3 (CLAC 74849):
Located 345 feet South and 395 feet West from the NE corner of Section 10, Township 2 South, Range 3 East (W.M.)

Well 4 (CLAC 74936):
Located 505 feet South and 635 feet West from the NE corner of Section 10, Township 2 South, Range 3 East (W.M.)

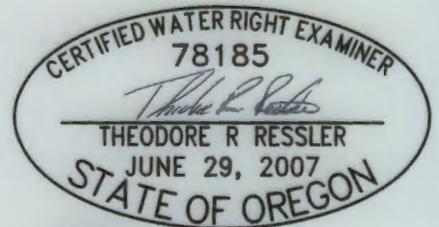

RENEWS: 12-31-2024

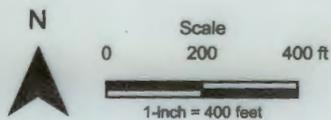

Date: 5/1/2024
Data Sources: METRO, ESRI, USGS
Disclaimer: This map is not intended to provide legal dimensions or property ownership lines.

