



Range 4 3 E.W.M.

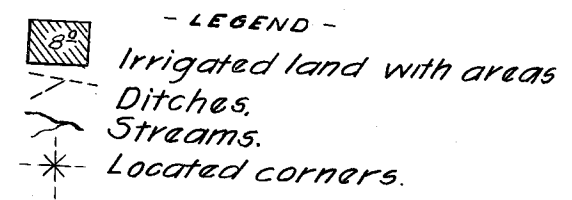

Adjudication Survey
Wallowa River
and
Tributaries.

T. 1 S. - R. 43 E.

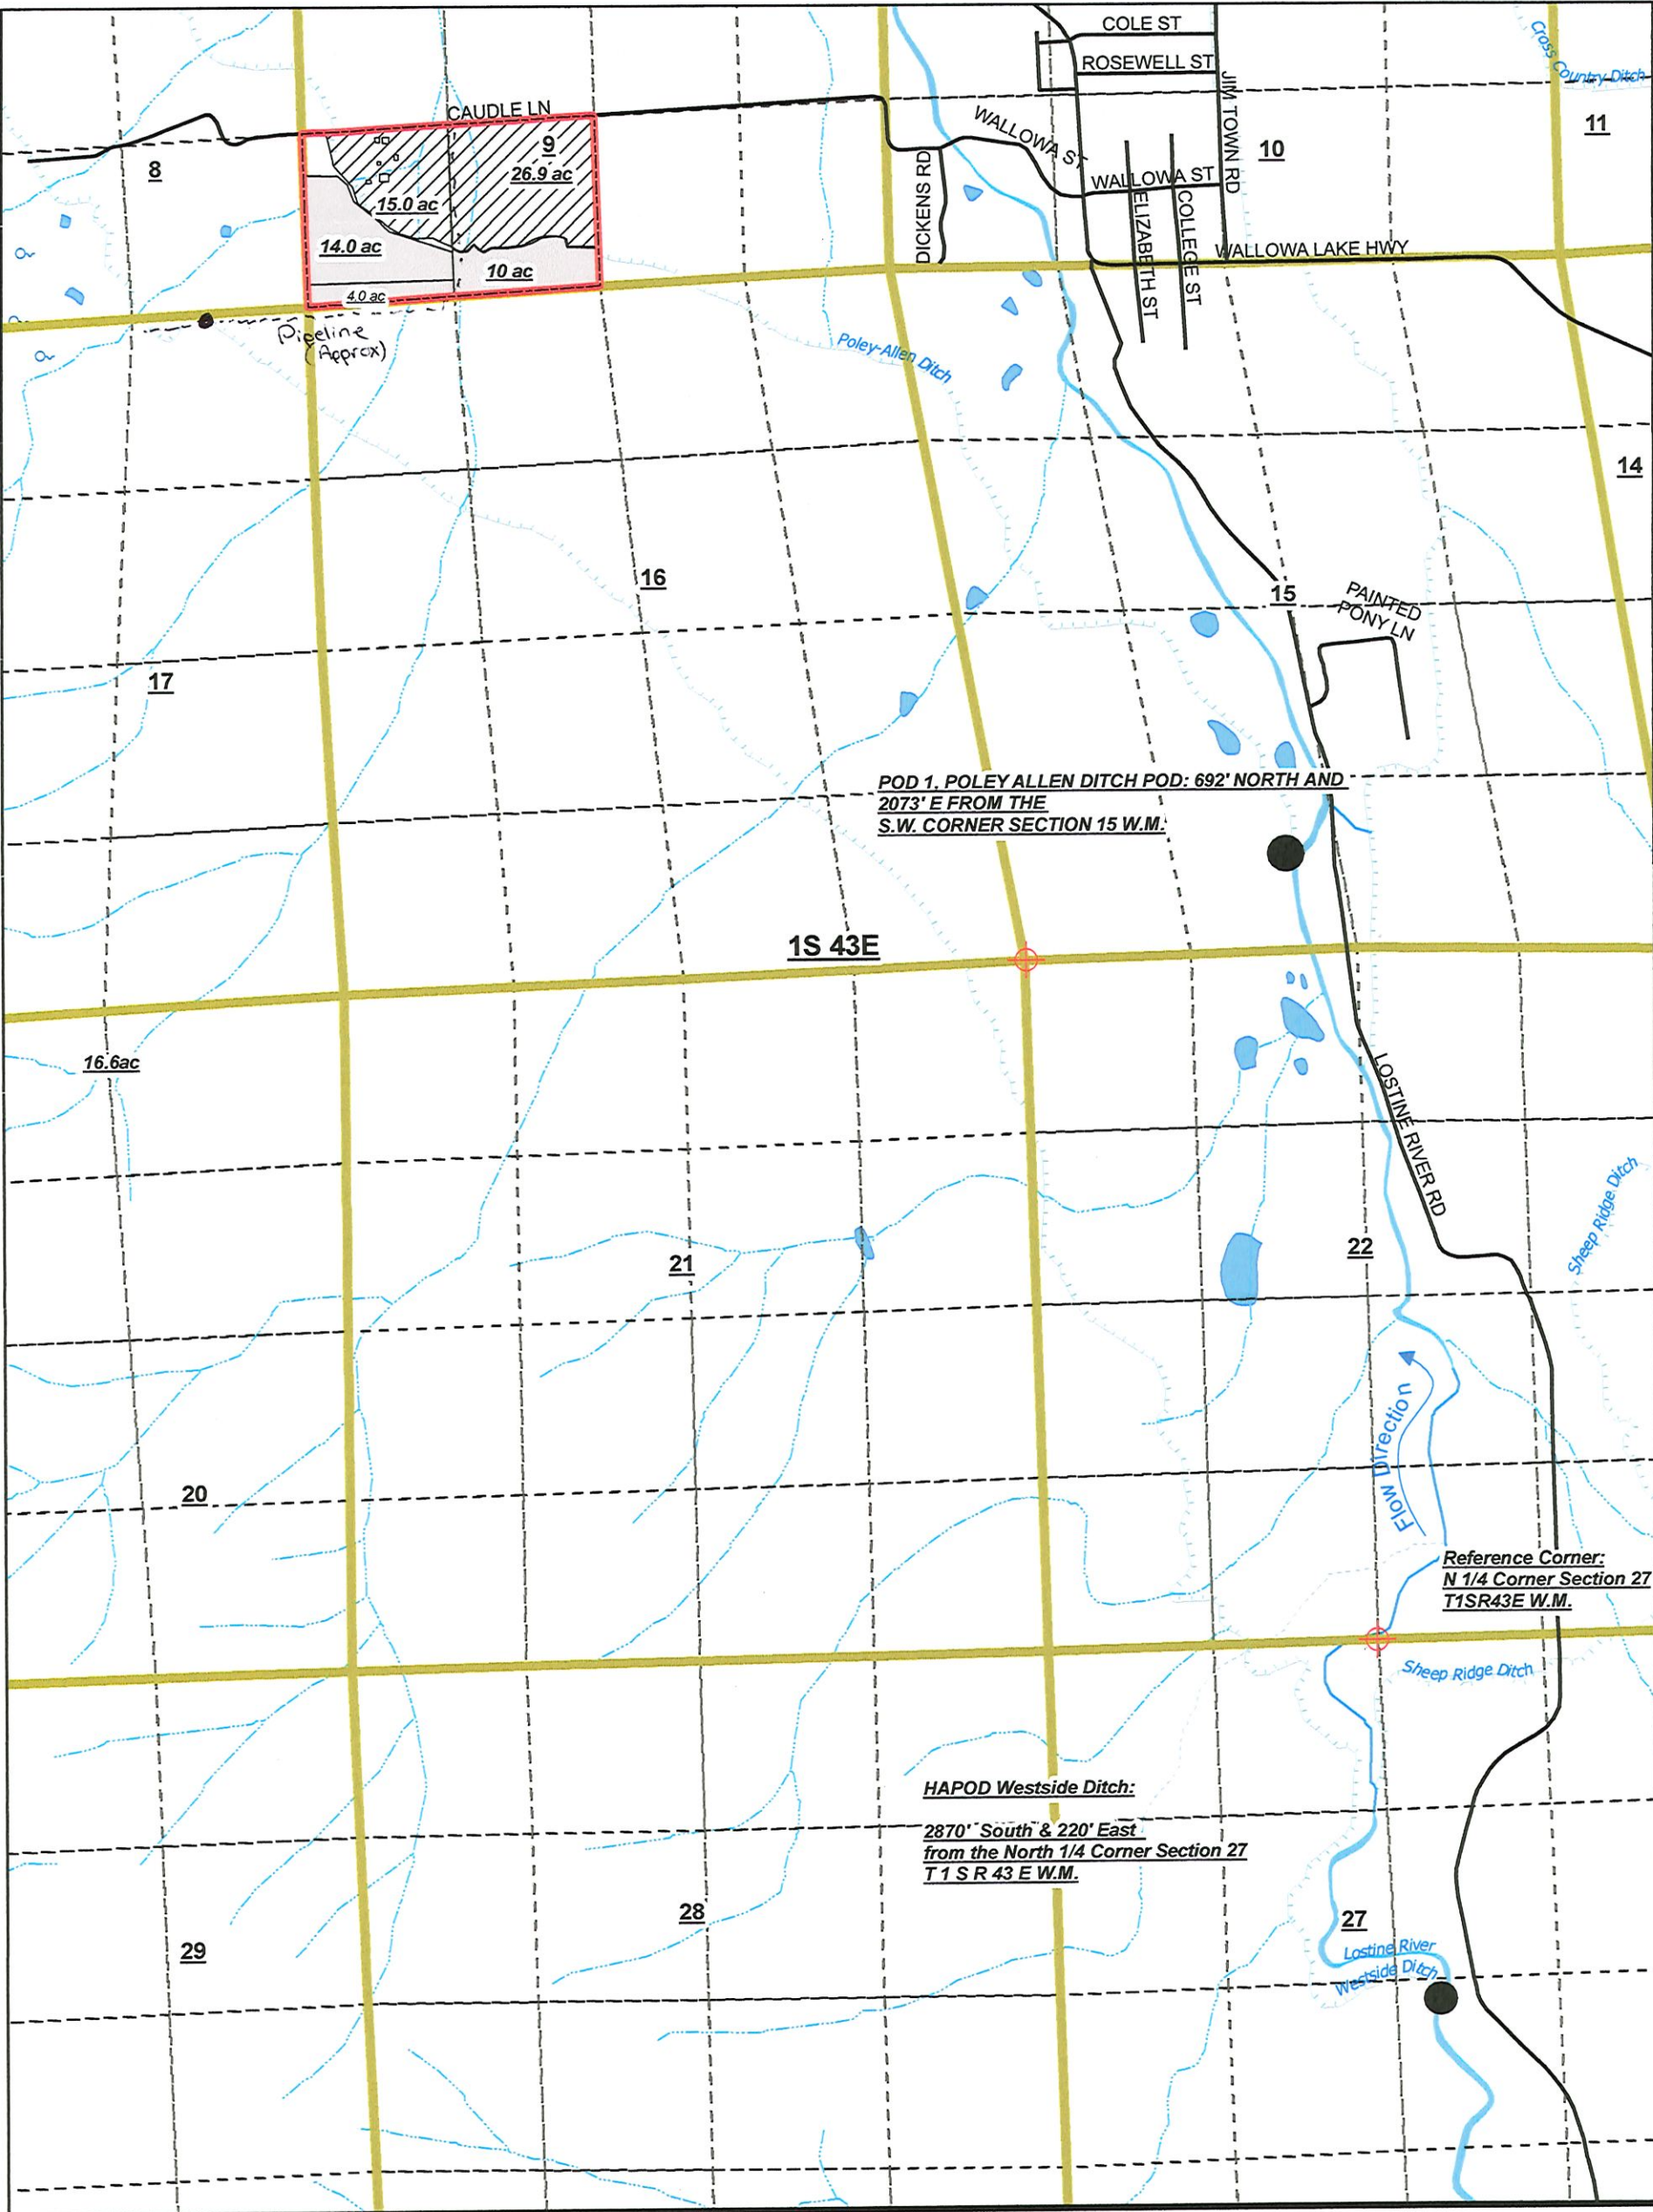

HISTORIC ADDITIONAL POD MAP: LARABEE 2024


Scale 1: 15840

- Legend
- Tax Lot 3700 Larabee
 - C 81644 West Side
 - C 2941 Poley Allen AHPOD
 - POINT OF DIVERSION
 - REFERENCE CORNER
 - Pipeline Location

Map Disclaimer:
This product is for informational purposes only and may not have been prepared for, or be suitable for, legal, engineering, or surveying purposes. Users of this information should review of consult the primary data and information sources to ascertain the usability of the information.
This map is not intended to display property lines.
Disclaimer: This listing is the result of a manual search of the records of the Watermaster's Plat Cards and the WRD database. This listing has not been field checked. That a right of record is no guarantee that it has not been abandoned under the conditions of ORS 540.610. The plat card records are listed by the 40.0 acre quarter-quarter within a section. If the water right listed within a quarter-quarter is on more than one tax lot, this office has not itemized the water rights for each tax lot - only a survey could accurately depict how much of the water rights are on each tax lot.



RECEIVED
JAN 24 2024
OWRD

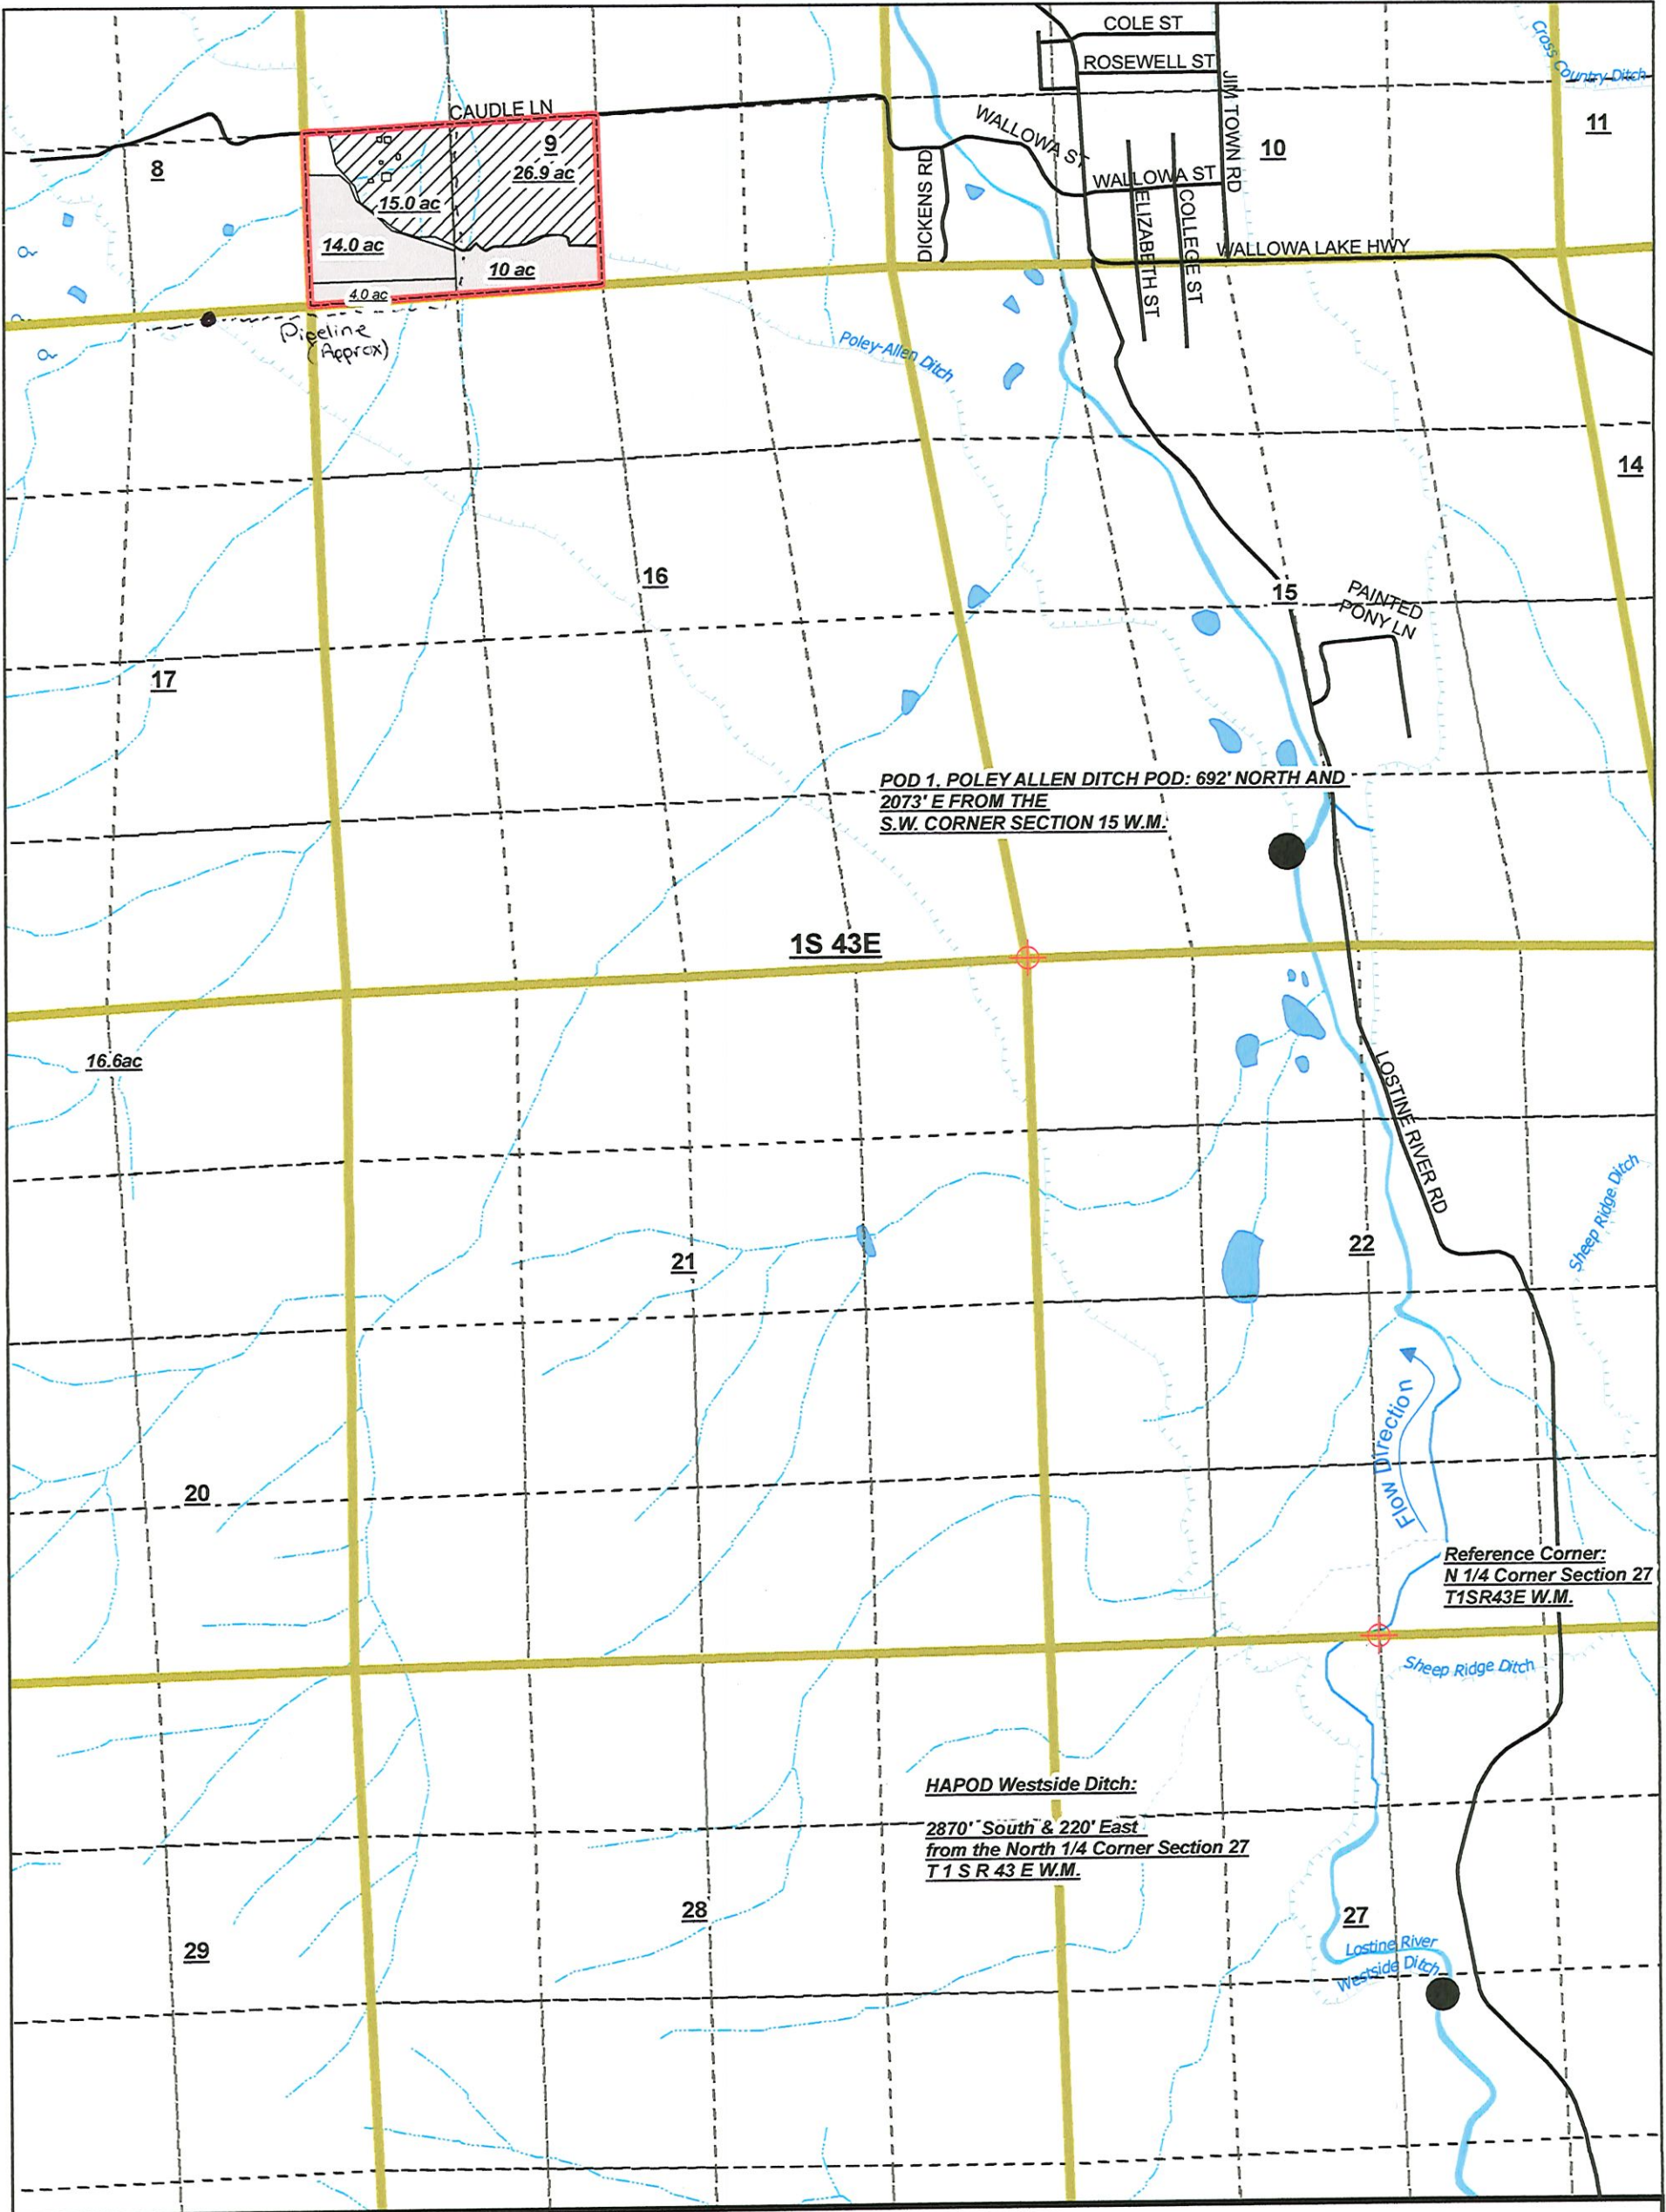

HISTORIC ADDITIONAL POD MAP: LARABEE 2024

Scale 1: 15840

Legend

- Tax Lot 3700 Larabee
- C 81644 West Side
- C 2941 Poley Allen AHPOD
- POINT OF DIVERSION
- REFERENCE CORNER
- Pipeline Location

Map Disclaimer:
This product is for informational purposes
and may not have been prepared for, or be suitable
for legal, engineering, or surveying purposes. Users of
this information should review of consult the
primary data and information sources to ascertain
the usability of the information.
This map is not intended to display property lines.

Disclaimer: This listing is the result of a manual search of the records of the Watermaster's Plat Cards
and the WMS database. This listing has not been field checked. There is no guarantee
that it has not been abandoned under the conditions of ORS 540.010. The plat card records are listed by
the 40.0 acre quarter-quarter within a section. If the water right listed within a quarter-quarter is on
more than one tax lot, this office has not determined the water rights for each tax lot - only a survey could
accurately depict how much of the water rights are on each tax lot.



RECEIVED
JAN 24 2024
OWRD