

T.2S. R.5E. Section 18, W.M.



12 7
13 18

Revenues
DLC 37

RECEIVED

FEB 27 2023

OWNED

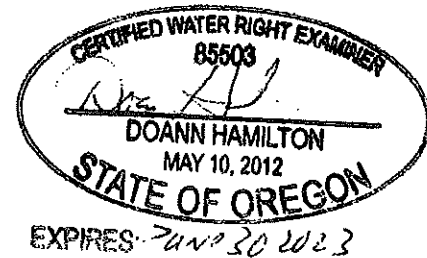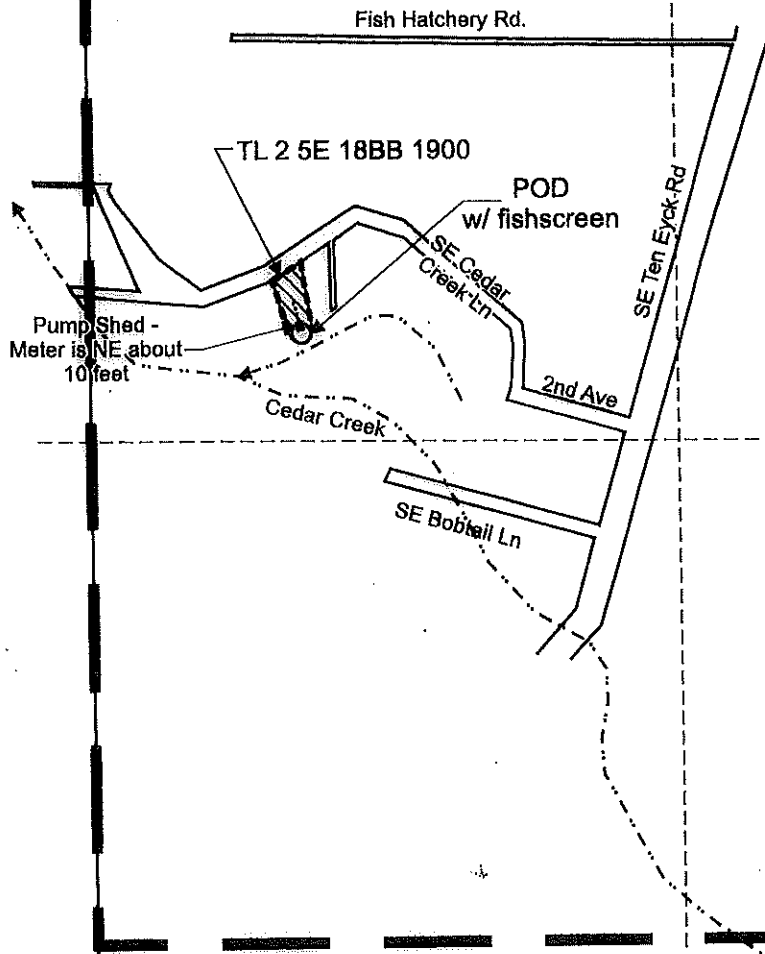

POD is located 1,070 feet south and 445 feet east from the NW corner, Section 18.

Area for human consumption for one household under Application S-87480, Permit S-54661

Tax lot boundary

Donation Land Claim boundary

Water main line, 1 inch, above and below ground

Scale: 1" = 400'



This map was prepared for the purpose of identifying the location of a water right only and is not intended to provide legal dimensions or location of property ownership lines.

Claim of Beneficial Use Map
Application S-87480, Permit S-54661

Lu Ann Russell
T.2S. R.5E. Section 18, W.M.

Pacific Hydro-Geology Inc.

01/2023