


Carbon Farm - Transfer POU - Certificate 3483

SUPERSEDING

REVISED 4/15/2024

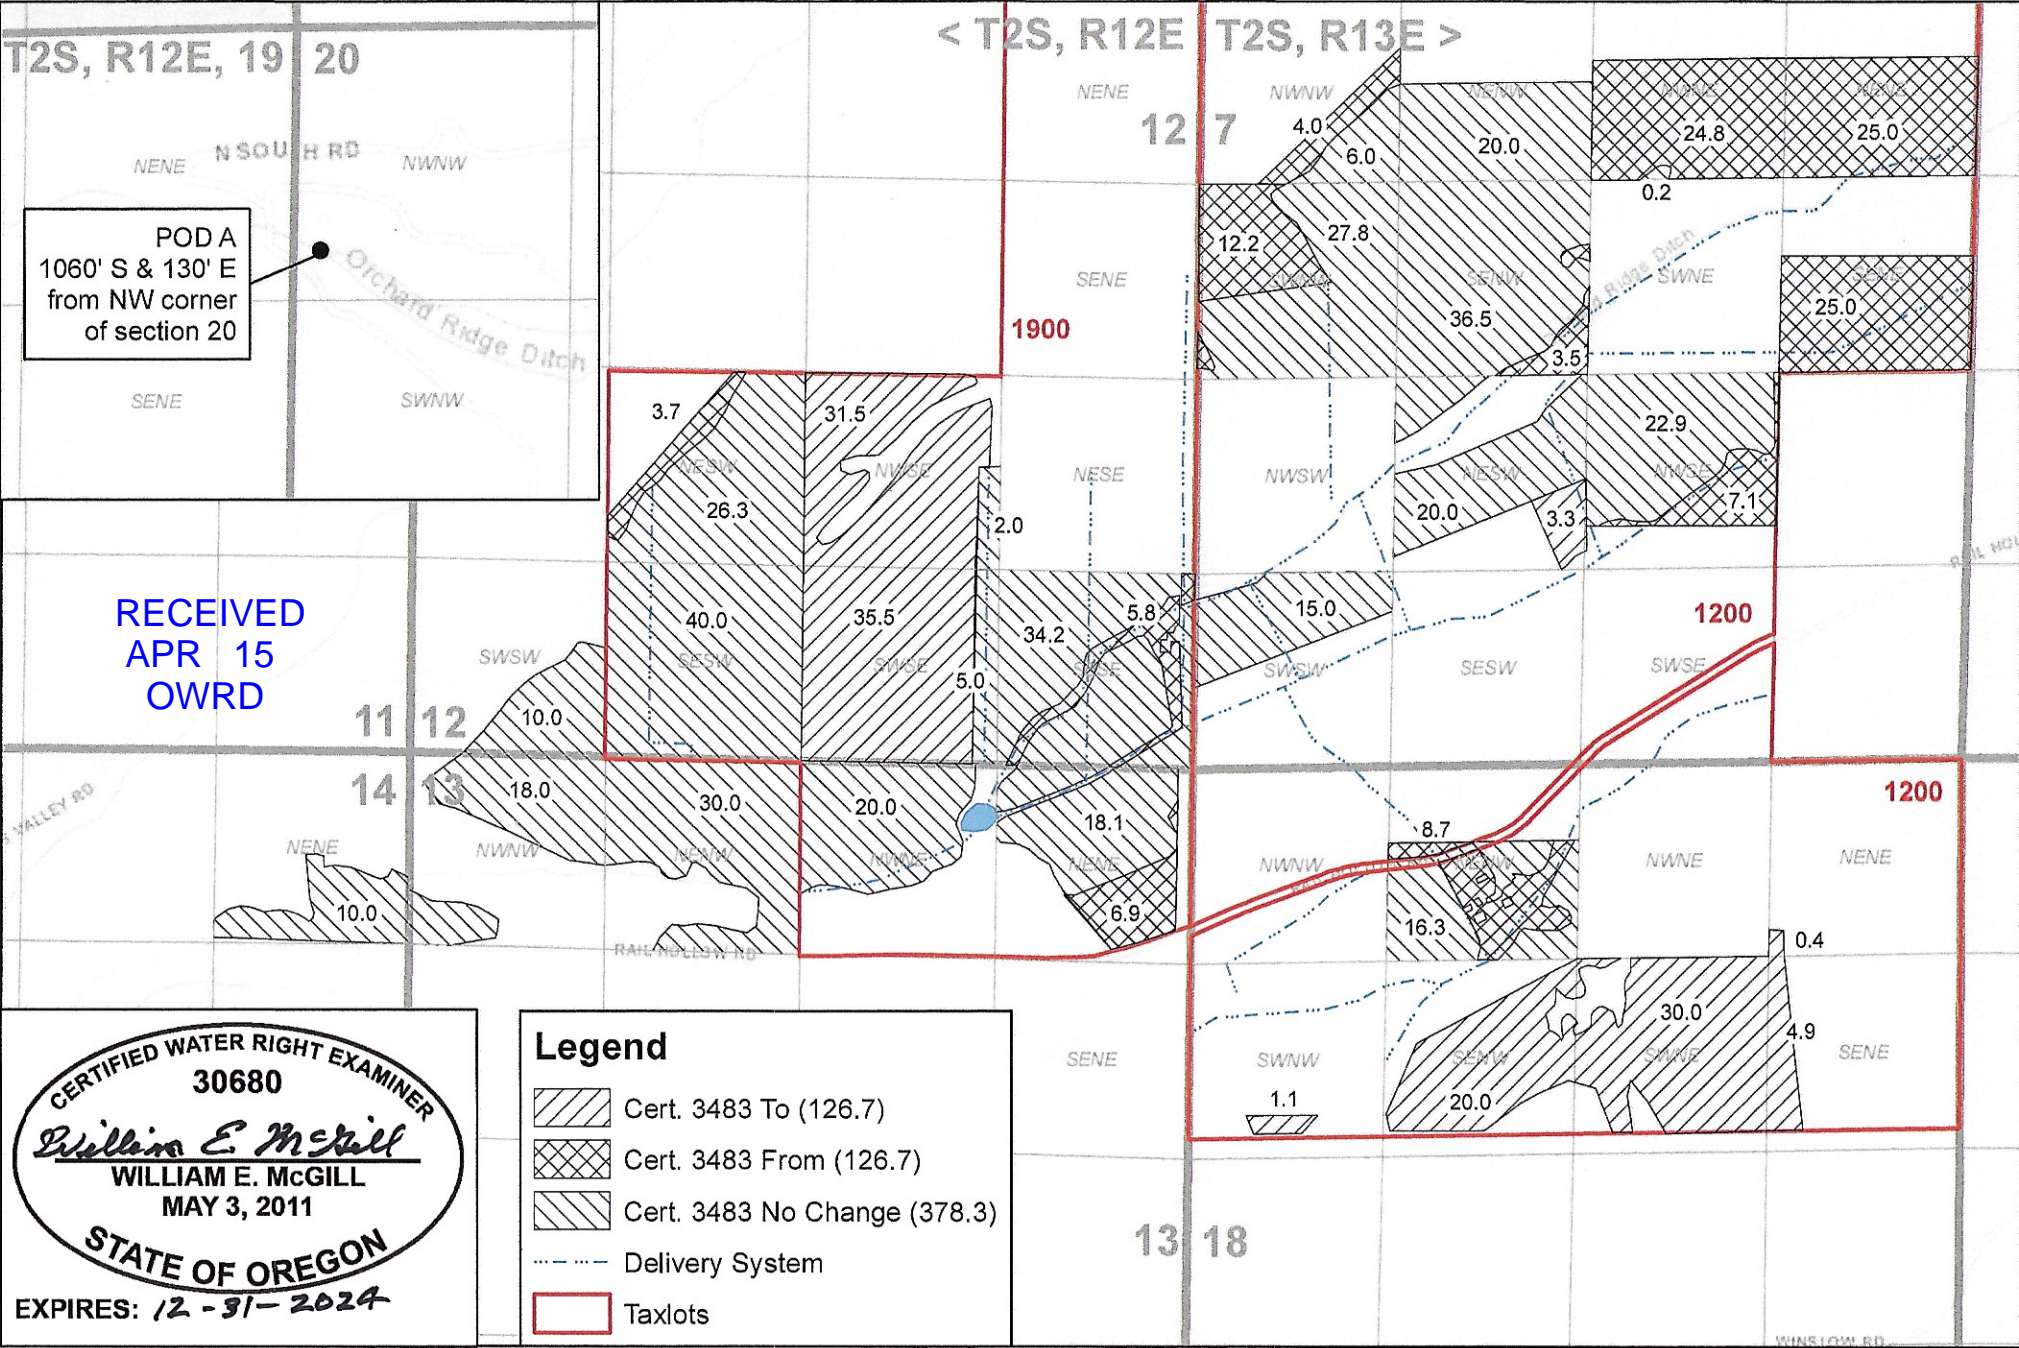


CERTIFIED WATER RIGHT EXAMINER
30680
William E. McGill
WILLIAM E. MCGILL
MAY 3, 2011
STATE OF OREGON
EXPIRES: 12-31-2024



MAP ORCHARD RIDGE DITCH

Scale 20 Ch = 1 Inch

Application # 367.
Permit # 151.

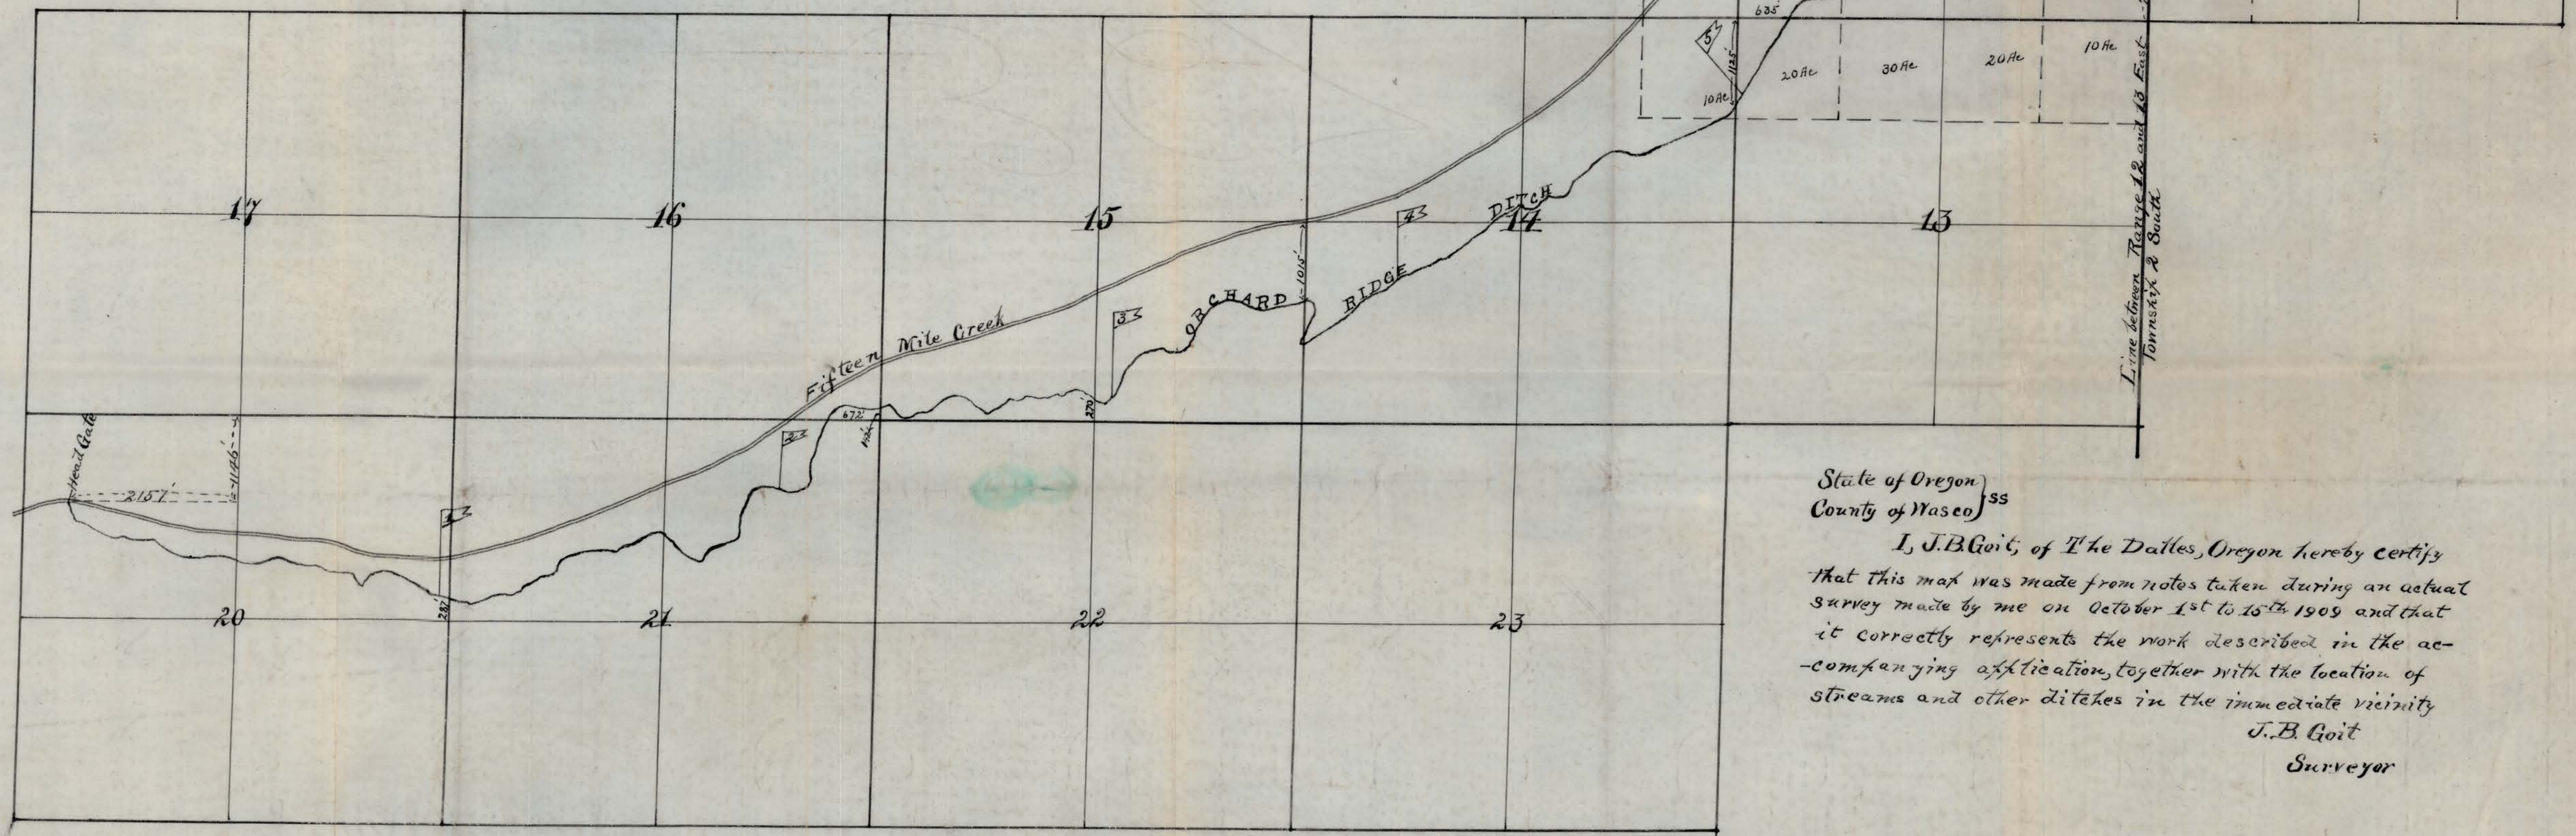

State of Oregon }
County of Wasco } ss

I, J.B. Goit, of The Dalles, Oregon hereby certify
that this map was made from notes taken during an actual
survey made by me on October 1st to 15th 1909 and that
it correctly represents the work described in the ac-
companying application, together with the location of
streams and other ditches in the immediate vicinity

J.B. Goit
Surveyor

367

367