



Carbon Farm - Transfer POU - Certificate 4841

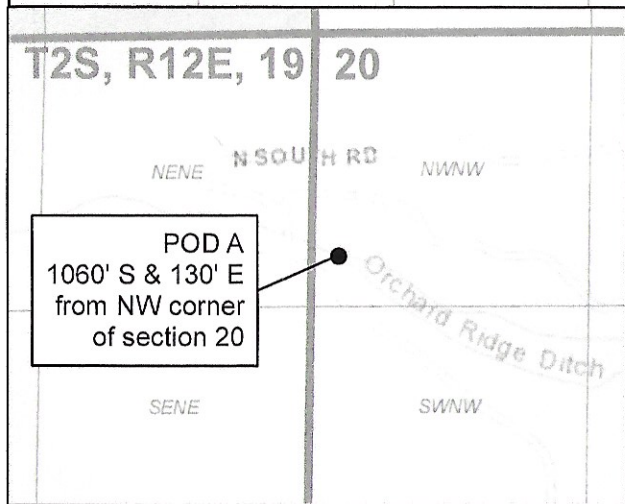

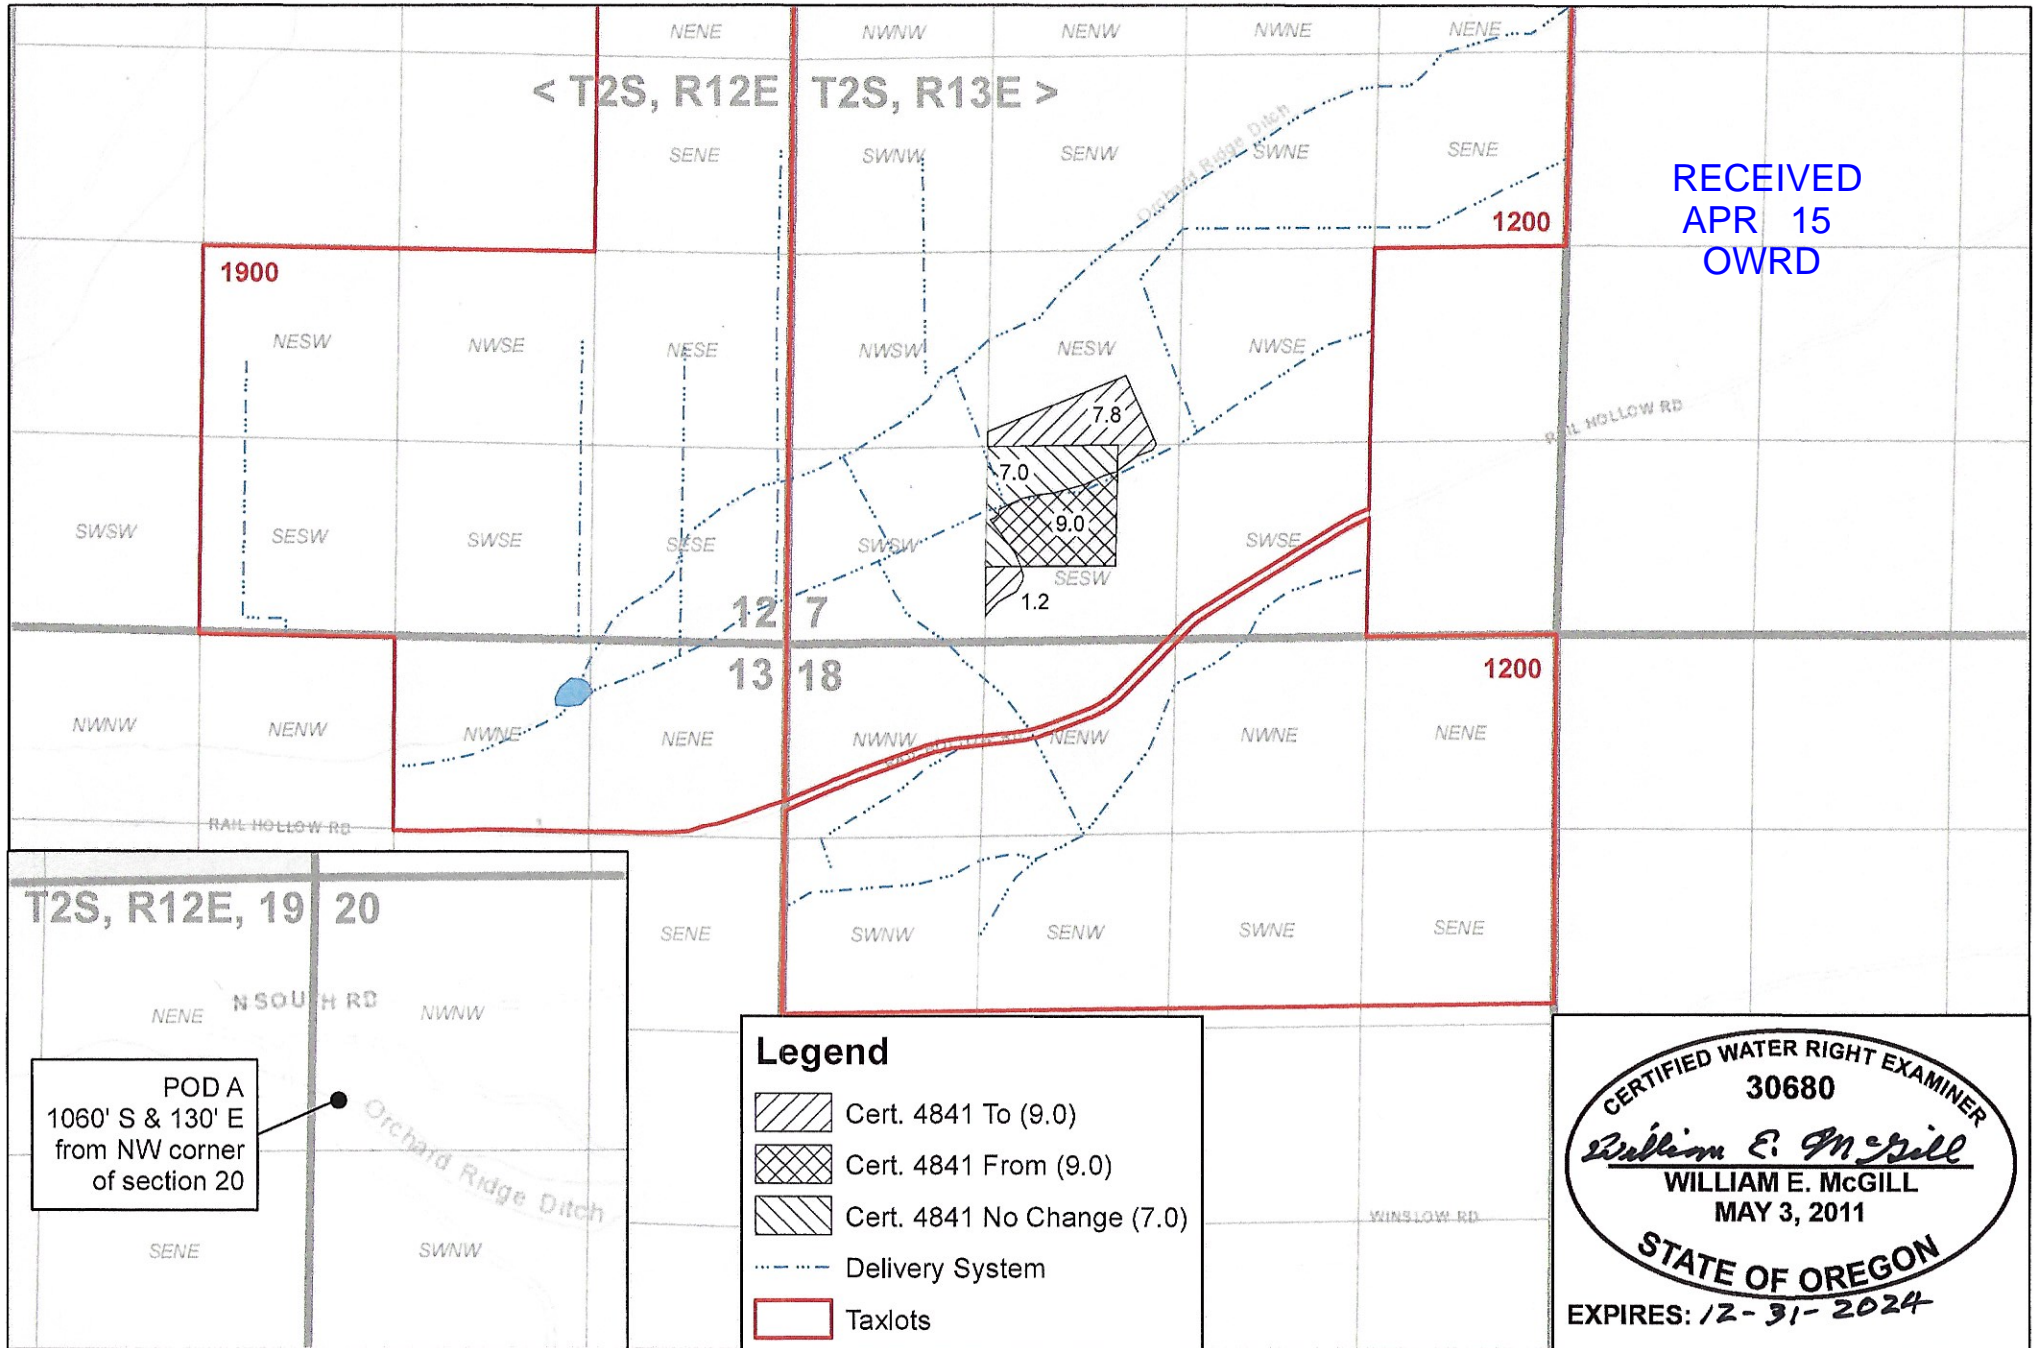


SUPERSEDING

REVISED 4/15/2024

RECEIVED
APR 15
OWRD

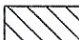

Legend

-  Cert. 4841 To (9.0)
-  Cert. 4841 From (9.0)
-  Cert. 4841 No Change (7.0)
-  Delivery System
-  Taxlots

CERTIFIED WATER RIGHT EXAMINER
30680
William E. McGill
 WILLIAM E. MCGILL
 MAY 3, 2011
 STATE OF OREGON
 EXPIRES: 12-31-2024

