


# Carbon Farm - Transfer POU - Certificate 8105

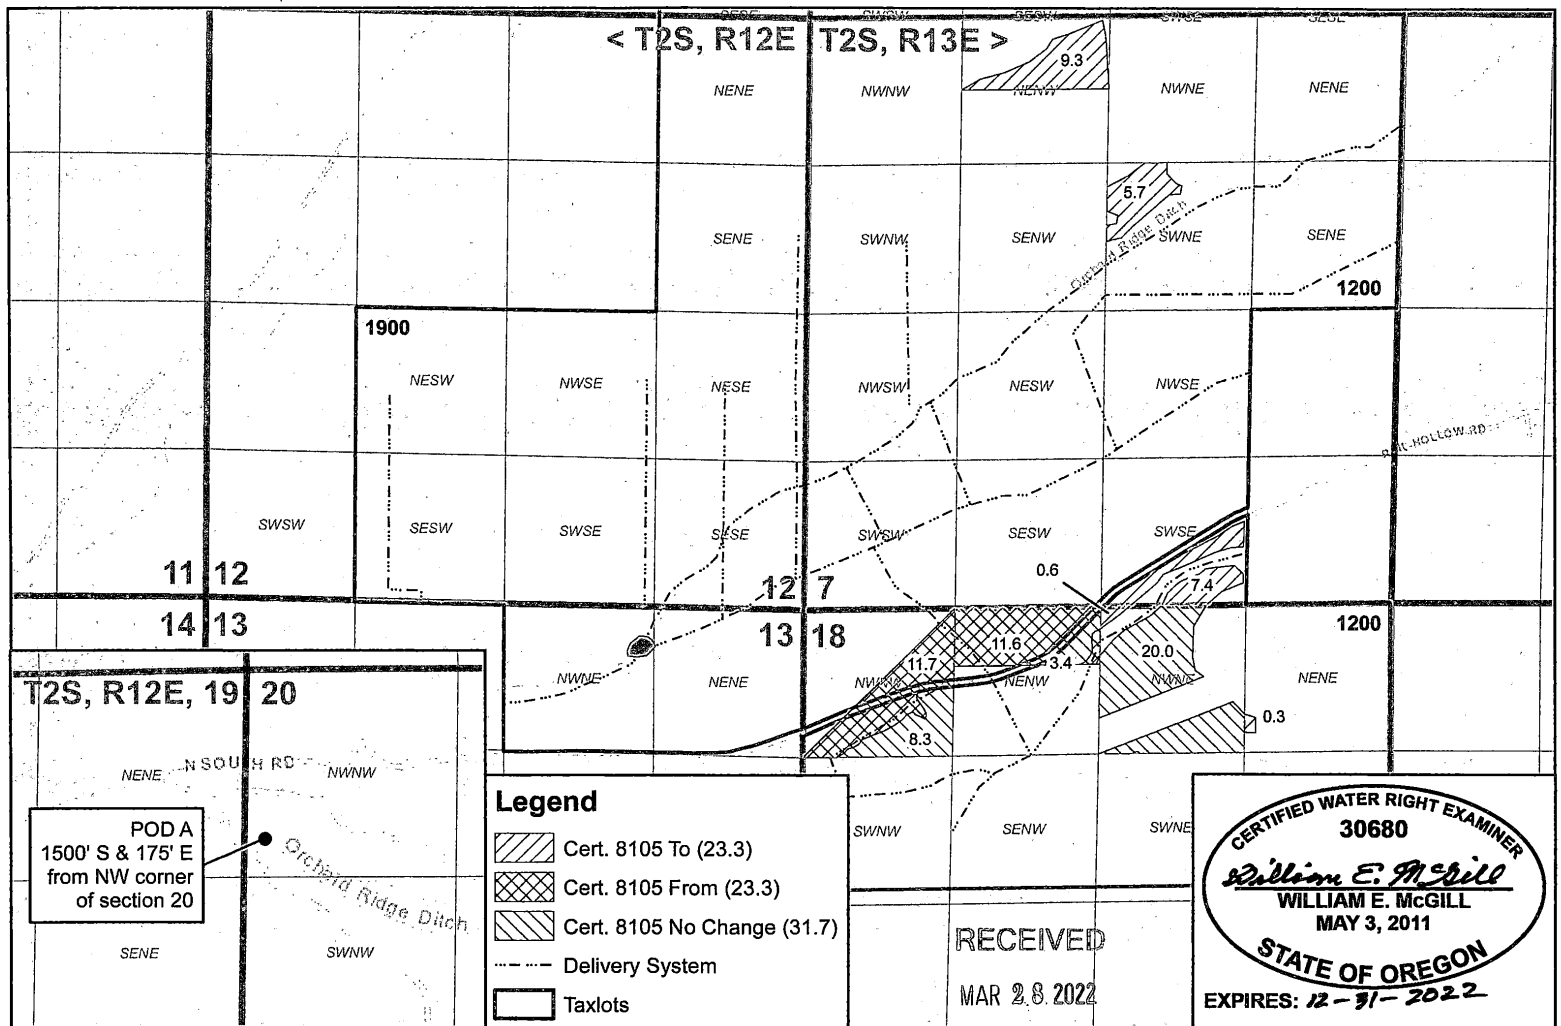

0 1,320 2,640 5,280 Feet

OWRD  
13956

WILL MCGILL SURVEYING LLC

Township 2 South



Range 12 E. W. M.

T

Map of Geo. W. Johnston

Page 1

Map of J  
Pa

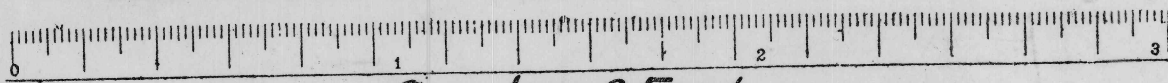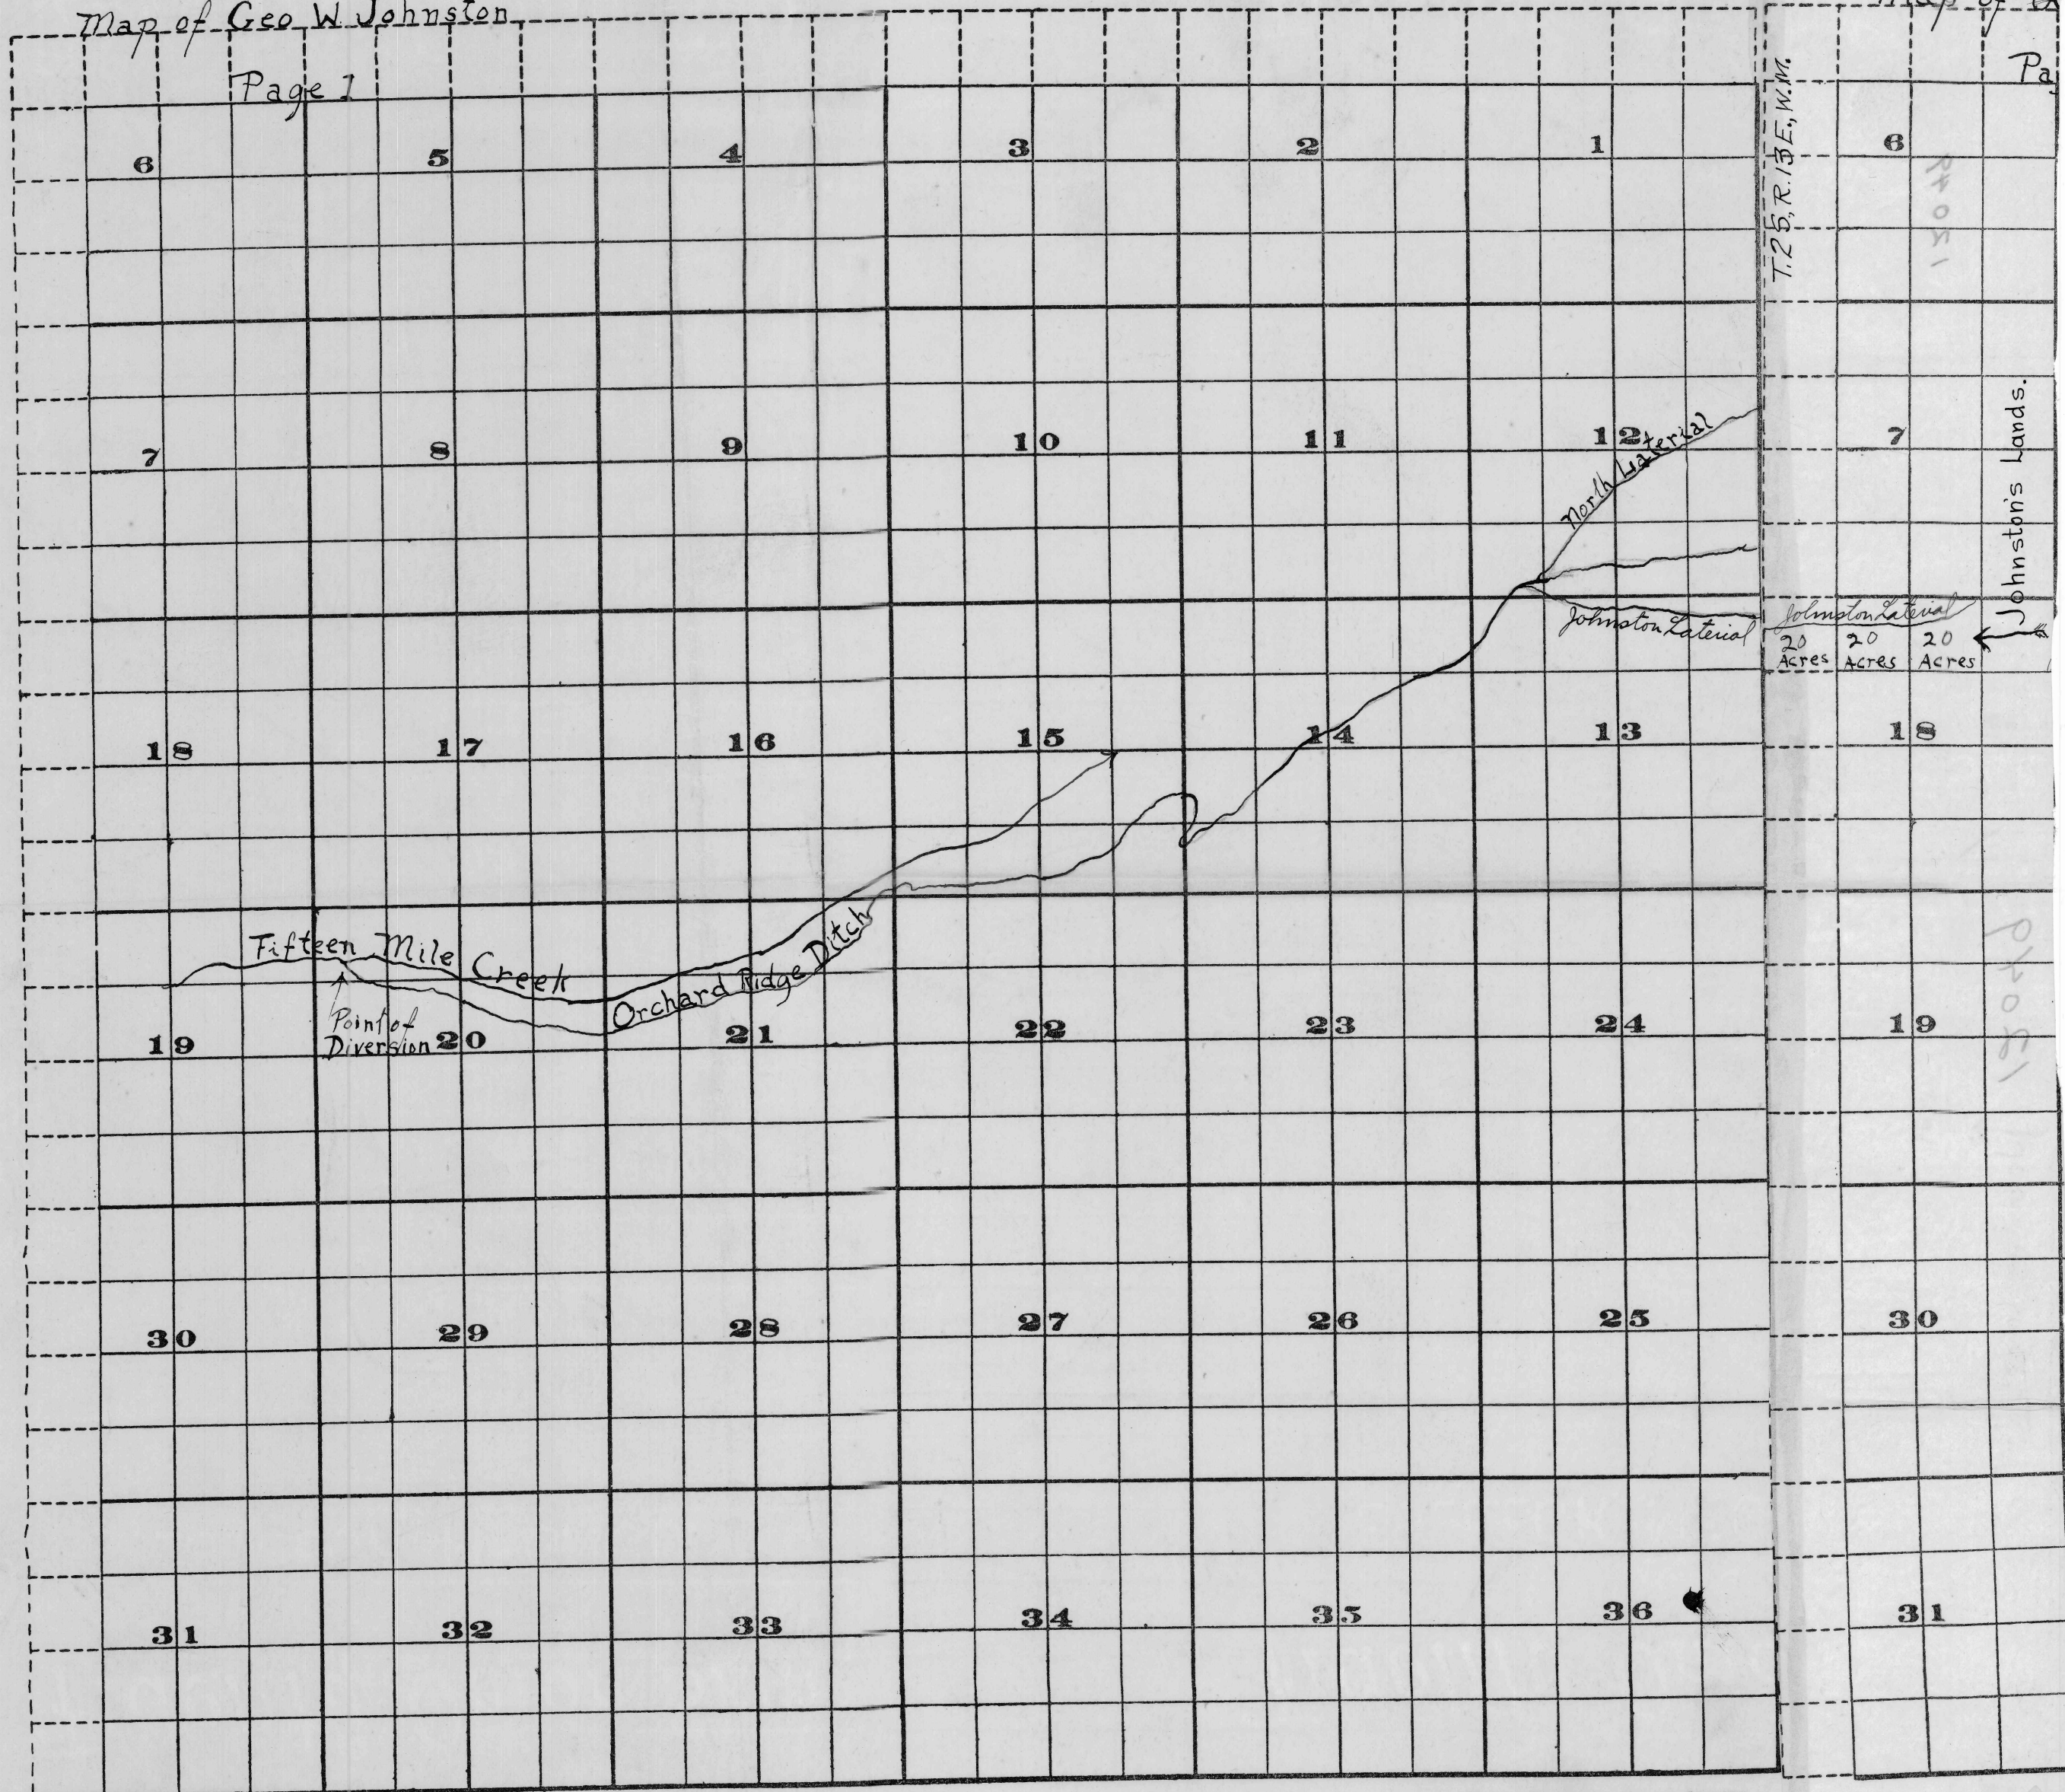

Scale of Feet.

FROM OFFICE OF THE STATE ENGINEER, SALEM, OREGON

Application No. 12049

Permit No. 8456