


T.5S. R.1E. Section 5, W.M.

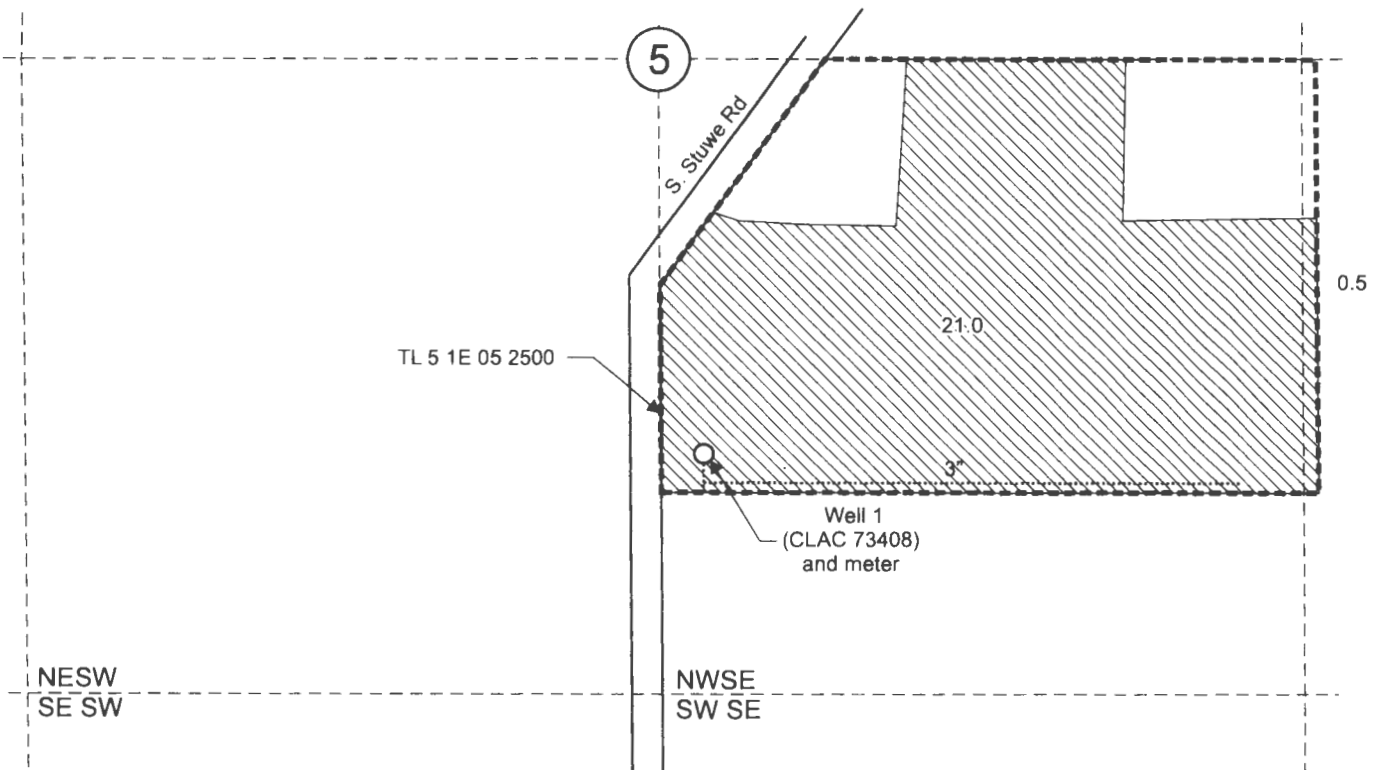

Well 1 (CLAC 73408) is located 820 feet south and 100 feet east from the center 1/4 corner, Section 5.

Area (21.5 Acres) irrigated under Application G-16595, Permit G-17337, T-11890.

----- Tax lot boundary

..... Water main line



S. Sconce Rd

Scale: 1" = 400'



This map was prepared for the purpose of identifying the location of a water right only and is not intended to provide legal dimensions or location of property ownership lines.

Claim of Beneficial Use Map
Application G-16595, Permit G-17337, T-11890

John "Jack" Hagan II and Pelagia "Polli" Hagan
T.5S. R.1E. Section 5, W.M.

Pacific Hydro-Geology Inc.

02/2024