
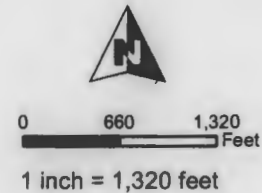


T32S R32E, WM


HARNEY COUNTY, OREGON

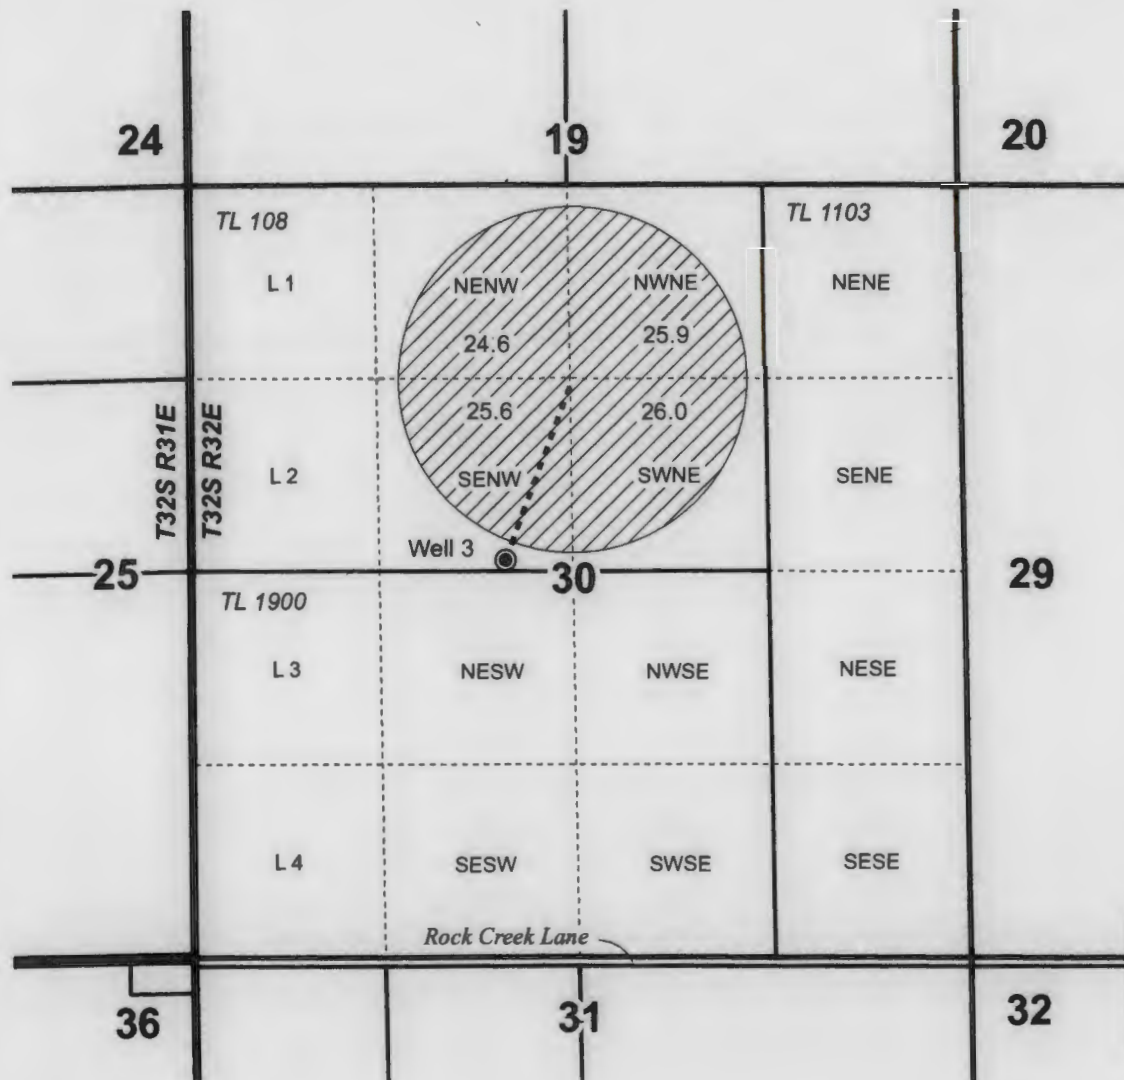

- Well & Meter
- Pipeline
- POU IR
- Township
- Section
- Quarter Quarter
- Tax Lot

Well #3 (HARN 52054 / L-113538) Location:
2570' S 2170' E of NW COR SEC 30

RECEIVED
JAN 02 2024
OWRD

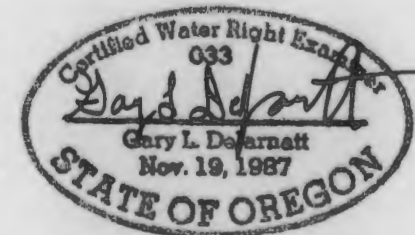

RENEWAL DATE 12/31/2023



CLAIM OF BENEFICIAL USE MAP

Rock Creek Ranch, Inc.

Date: 10/11/2023

PROJECT #23051

NOTE: THIS MAP IS NOT INTENDED TO
PROVIDE LEGAL DIMENSIONS OR LOCATIONS
OF PROPERTY OWNERSHIP LINES.

AP G-17582 / T-12912 / PERMIT G-18438

WATER RIGHT SERVICES, LLC

PO BOX 1830, BEND, OR 97709

CCB# 197121 www.oregonwater.us

541-389-2837 JOHNSHORT@USA.COM