

RECEIVED

FINAL PROOF SURVEY

AUG 19 1996

SITUATED IN THE NE1/4 NE1/4 OF SECTION 36,
T37S, R11 1/2EWM, KLAMATH COUNTY, OREGON.

WATER RESOURCES DEPT.
SALEM, OREGON

AUGUST, 1996

APPLICATION # G-12790


PERMIT # G-11625

MAP PREPARED FOR

--MIKE AND DONNA RUSSELL--

MAP PREPARED FROM

--FIELD SURVEY--
--APPLICATION MAP--

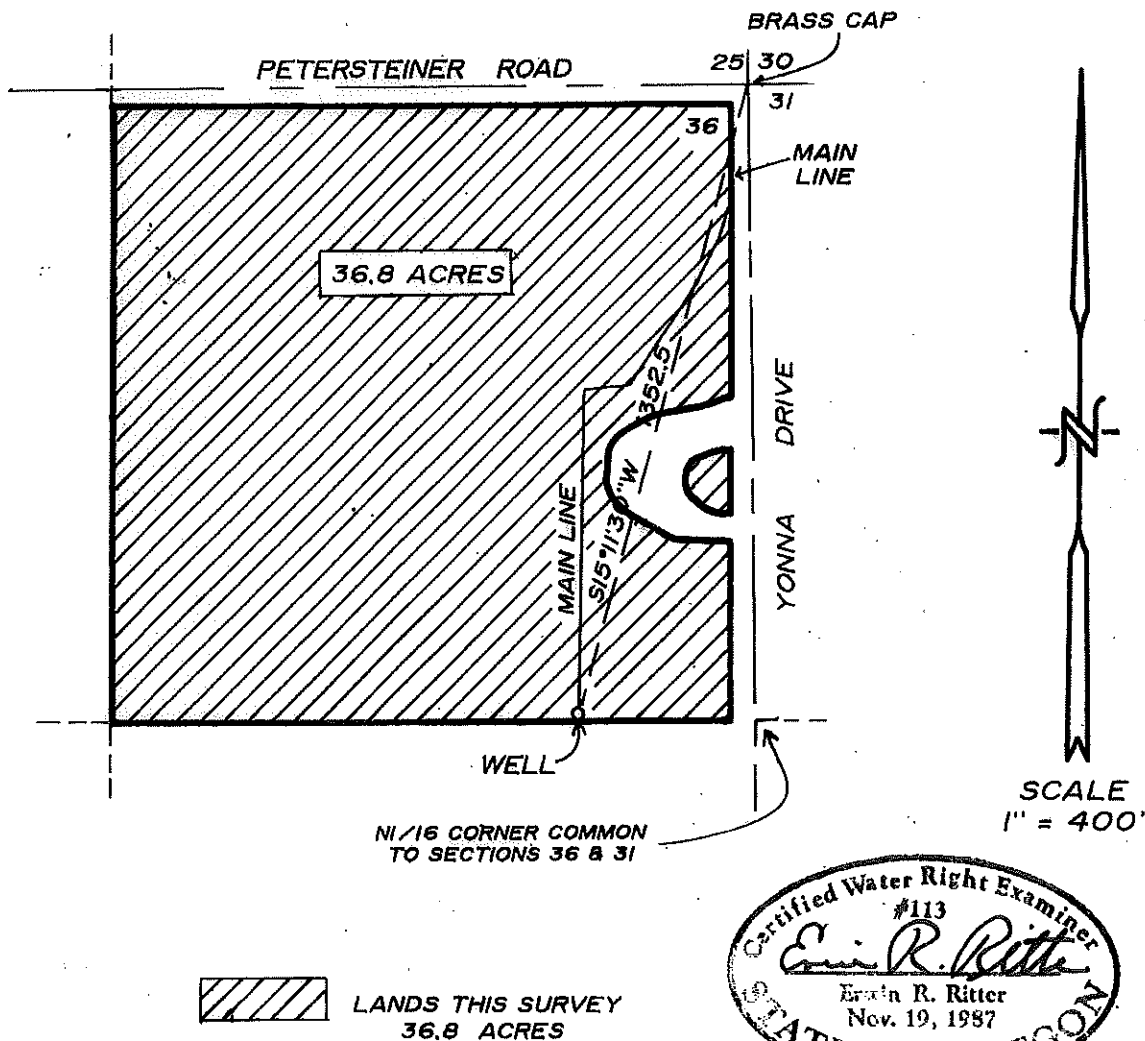

THE PURPOSE OF THIS MAP IS TO IDENTIFY THE LOCATION OF THE WATER RIGHT. IT IS NOT INTENDED TO PROVIDE INFORMATION RELATIVE TO THE LOCATION OF PROPERTY OWNERSHIP BOUNDARY LINES.

TRU-LINE SURVEYING, INC.
2333 SUMMERS LANE
KLAMATH FALLS, OR. 97603