


N

T. 5 S., R. 1 E., W. M.



SE 1/4 NE 1/4
SEC. 8

SW 1/4 NW 1/4
SEC. 9

SCALE: 1" = 400'

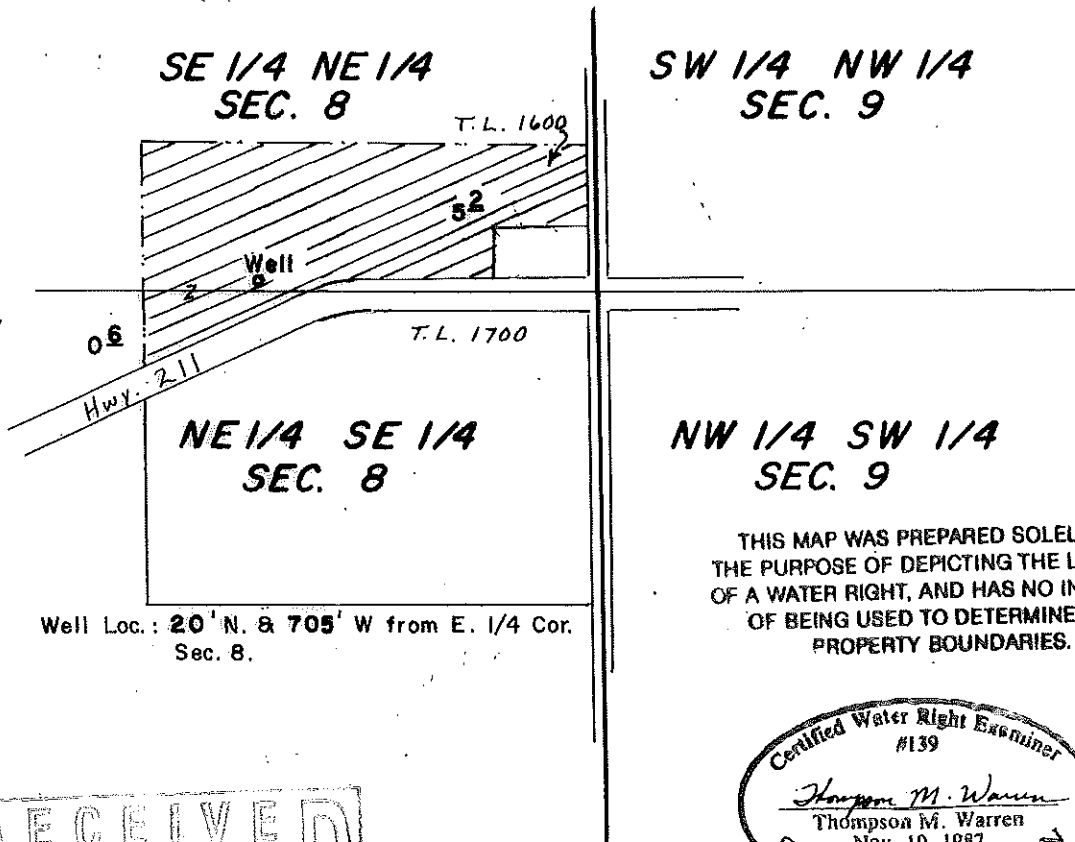

THIS MAP WAS PREPARED SOLELY FOR
THE PURPOSE OF DEPICTING THE LOCATION
OF A WATER RIGHT, AND HAS NO INTENTION
OF BEING USED TO DETERMINE REAL
PROPERTY BOUNDARIES.

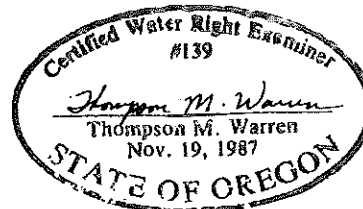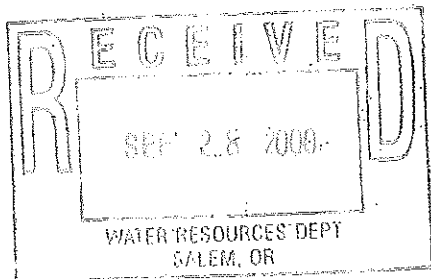

FINAL PROOF SURVEY
UNDER

Application No. G-12986

Permit No. G-12337

IN NAME OF

HAROLD M. MILLER

Surveyed 09/16/2000, by Thom Warren

CHAIN
SURVEY