


Claim of Beneficial Use Map

Section 19, T.5N., R.36E., WM
Umatilla County, Oregon

RECEIVED


SEP 26 2022

OWRD

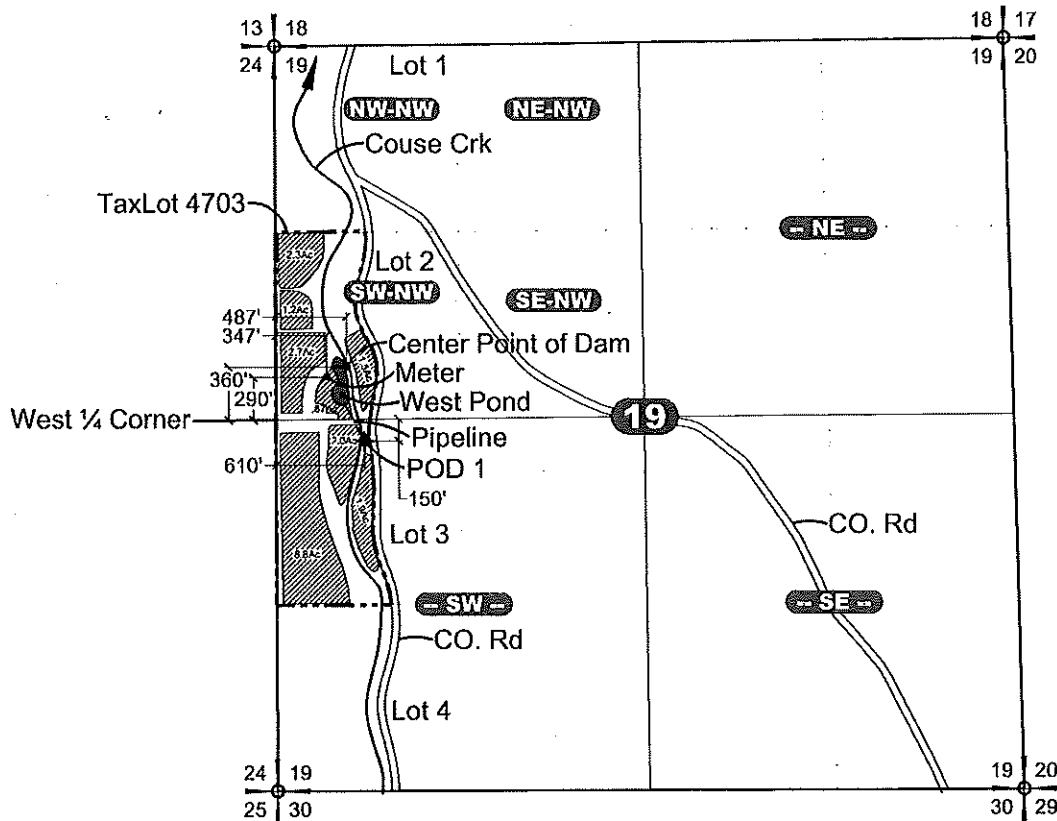


NOTES

1. Fish Screen is located at POD #1.
2. The connection to the primary irrigation system is located approximately 1.2 Feet from the meter.
3. This map was prepared for the purpose of identifying the location of water rights only and is not intended to provide legal dimensions or locations of property ownership lines.
4. Base Map Source:
Final Proof Map for Application 69183 for Certificate 86341
Umatilla County Tax Map 5N36E

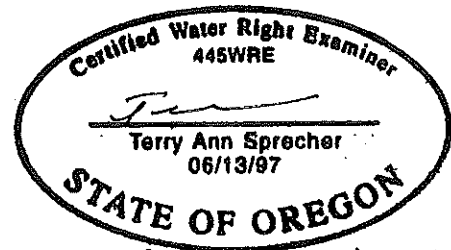

LEGEND

- ⊕ Location of Center of Dam.
- ⊙ Location of POD and Fish Screen. For Certificate 86341 & Permit R-13591.
- - - Tax Lot Boundary
- ▨ 1.5Ac Supplemental Irrigation and Number of Acres

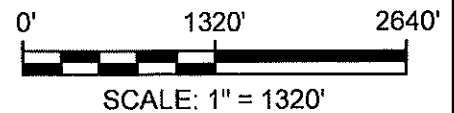

FIGURE

1

Claim of Beneficial Use Map
Application S-85433, Permit S-53977
82168 Couse Creek Rd
Milton-Freewater, OR 97862

CREATED BY: TAS
DRAWN BY: SJS

soil
service water
Sprecher
group
2445 NE Division St., Suite 300
Bend, Oregon 97703

SG PROJECT 4373
JULY 2022