

APPLICATION FOR PERMANENT WATER RIGHT TRANSFER

FOR
EDGEWOOD RANCH INC.

T37S, R10E, Sec. 8, 9, 14, 15, 16, 17, 19,
20, 21, 22, 23, 26, 27, 28, & 29, W.M.


KLAMATH COUNTY, OREGON

CERTIFICATE 92375

APPLICATION No. G-7873

PERMIT No. G-7293

- LEGEND**
- SECTION LINE
 - 1/4 1/4 LINE
 - TAX LOT LINE
 - CREEK
 - DITCH LINE
 - BURIED PIPE
 - ROAD
 - WATER PUMP
 - FLOW DIRECTION
 - SECTION CORNER
 - TAX LOT NUMBER
 - POA (WELL)
 - CERTIFICATE 92375 REMAINING LANDS
 - CERTIFICATE 92375 TRANSFERRED "FROM" LANDS
 - CERTIFICATE 92375 TRANSFERRED "TO" LANDS
 - LANDS TO REMAIN UNCHANGED 1/4 1/4 SECTION
 - LANDS TO BE TRANSFERRED "FROM" 1/4 1/4 SECTION
 - LANDS TO BE TRANSFERRED "TO" 1/4 1/4 SECTION

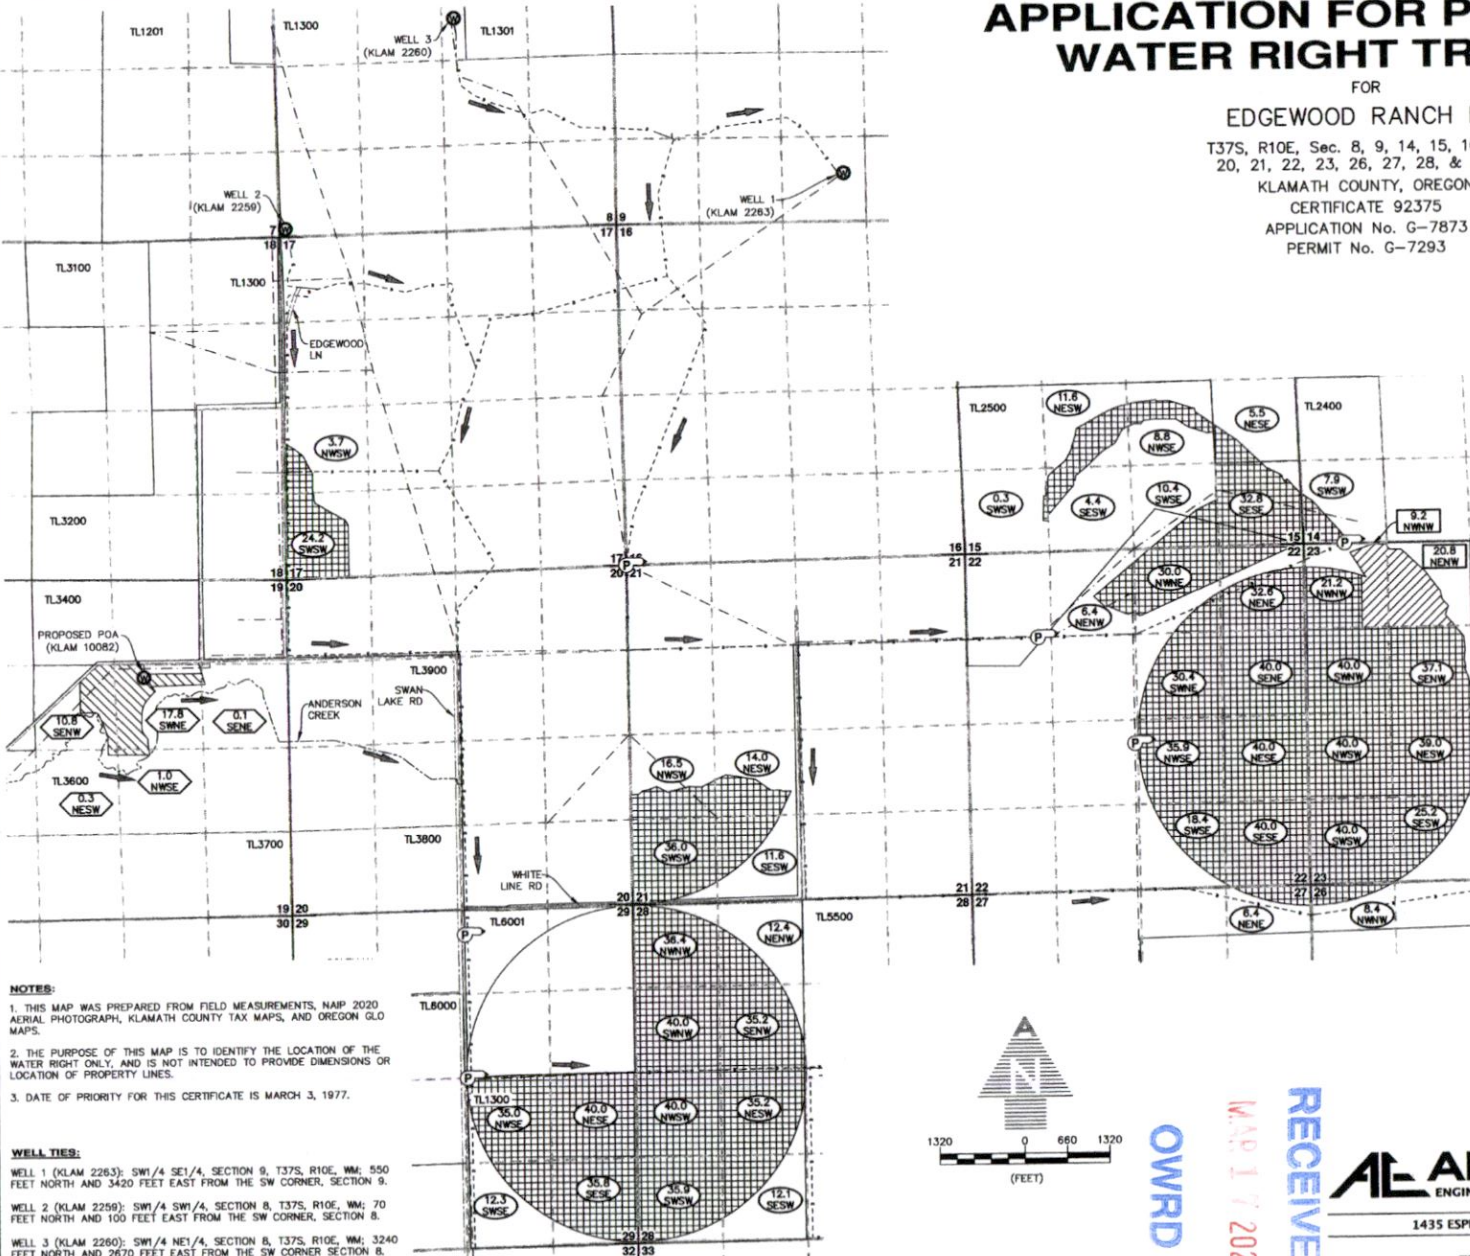


NOTES:

- THIS MAP WAS PREPARED FROM FIELD MEASUREMENTS, NAIP 2020 AERIAL PHOTOGRAPH, KLAMATH COUNTY TAX MAPS, AND OREGON GLO MAPS.
- THE PURPOSE OF THIS MAP IS TO IDENTIFY THE LOCATION OF THE WATER RIGHT ONLY, AND IS NOT INTENDED TO PROVIDE DIMENSIONS OR LOCATION OF PROPERTY LINES.
- DATE OF PRIORITY FOR THIS CERTIFICATE IS MARCH 3, 1977.

WELL TIES:


- WELL 1 (KLAM 2263): SW1/4 SE1/4, SECTION 9, T37S, R10E, WM; 550 FEET NORTH AND 3420 FEET EAST FROM THE SW CORNER, SECTION 9.
- WELL 2 (KLAM 2259): SW1/4 SW1/4, SECTION 8, T37S, R10E, WM; 70 FEET NORTH AND 100 FEET EAST FROM THE SW CORNER, SECTION 8.
- WELL 3 (KLAM 2260): SW1/4 NE1/4, SECTION 8, T37S, R10E, WM; 3240 FEET NORTH AND 2670 FEET EAST FROM THE SW CORNER SECTION 8.
- PROPOSED POA (KLAM 10082): T37S, R10E, W.M., SEC. 19, SW1/4 NE1/4; 1630 FEET SOUTH & 2220 FEET WEST FROM NE CORNER, SECTION 19.

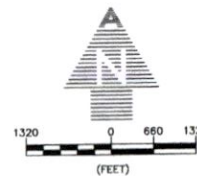

OWRD

MAY 17 2021

RECEIVED

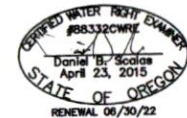

AL ADKINS o / 541.884.4666
ENGINEERING & SURVEYING w / AdkinsEngineering.com

1435 ESPLANADE AVENUE, KLAMATH FALLS, OR 97601

SERVING S. OREGON & N. CALIFORNIA


ENGINEERING • SURVEYING • PLANNING • TESTING
CERTIFICATE 92375

2/15/2021

3431-02


13648-

T. 37 S., R. 10 E., WM.

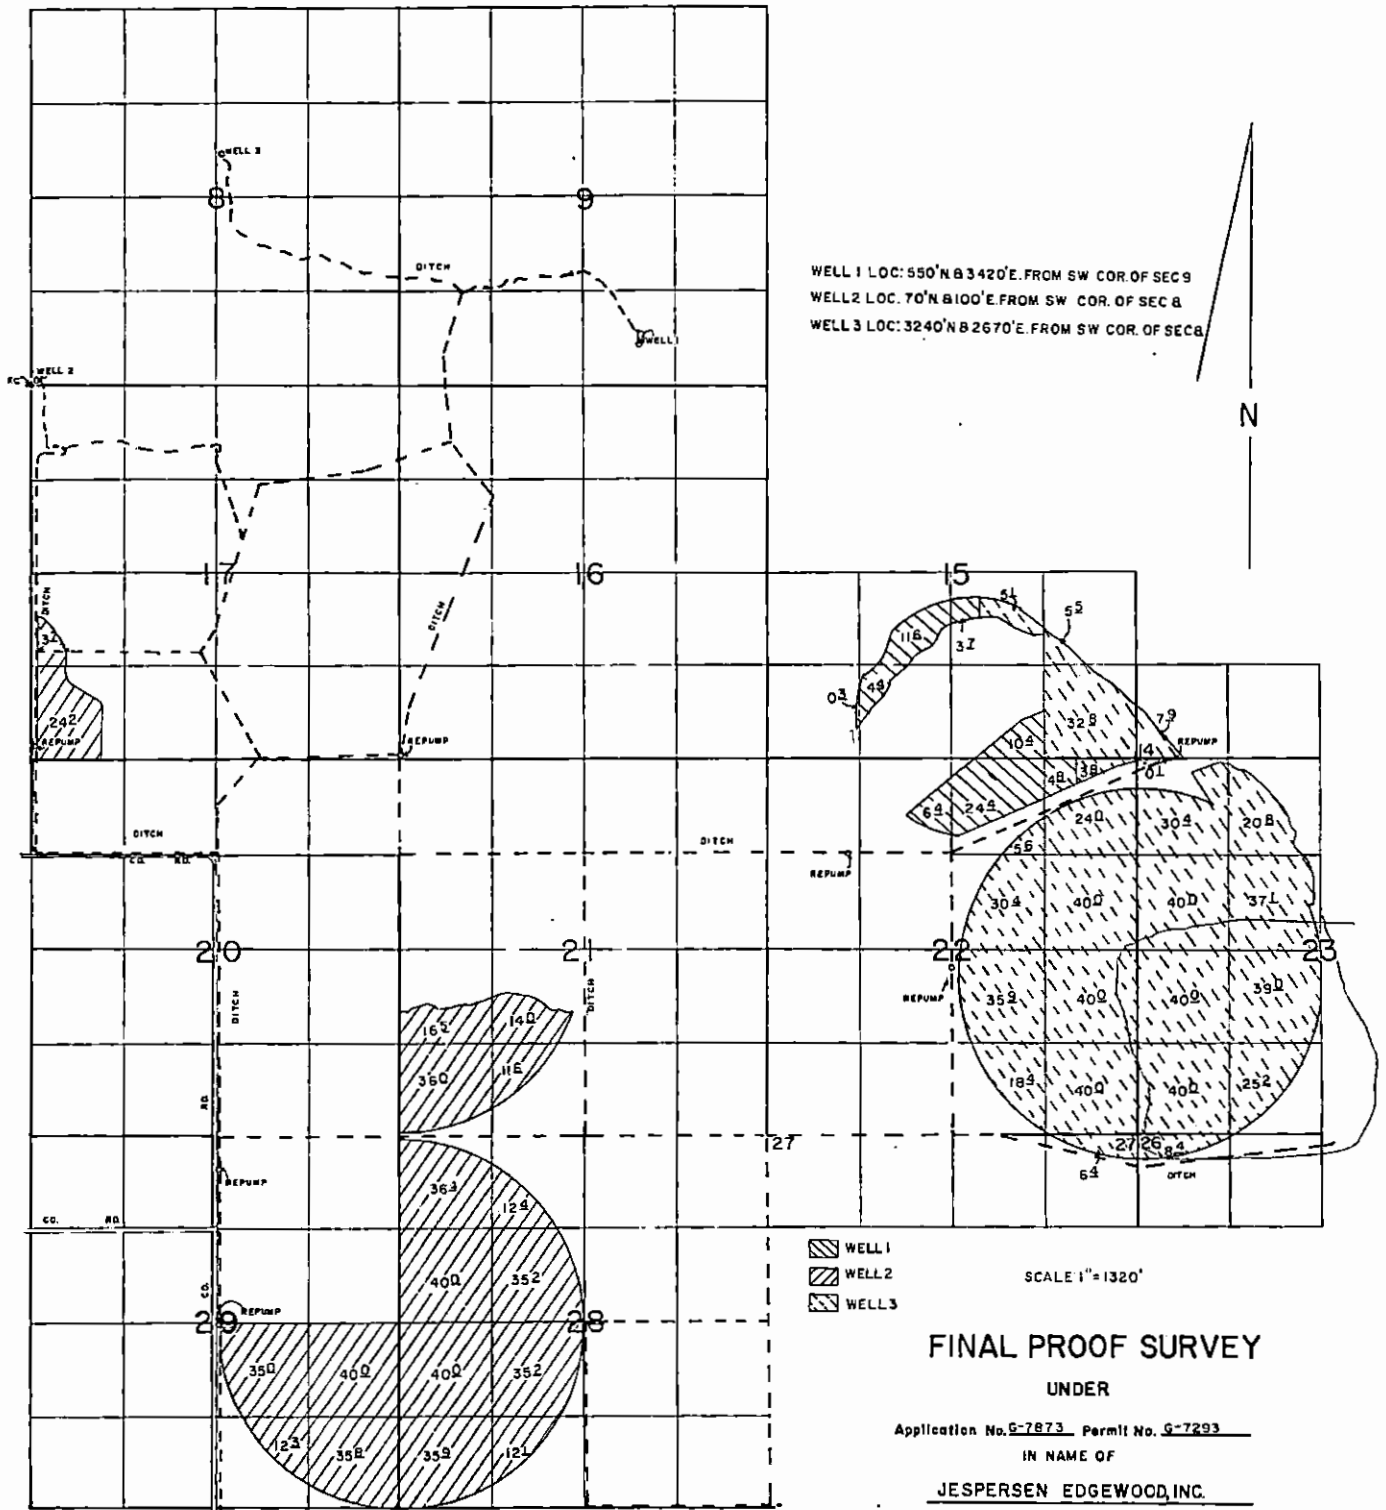

#122

0114

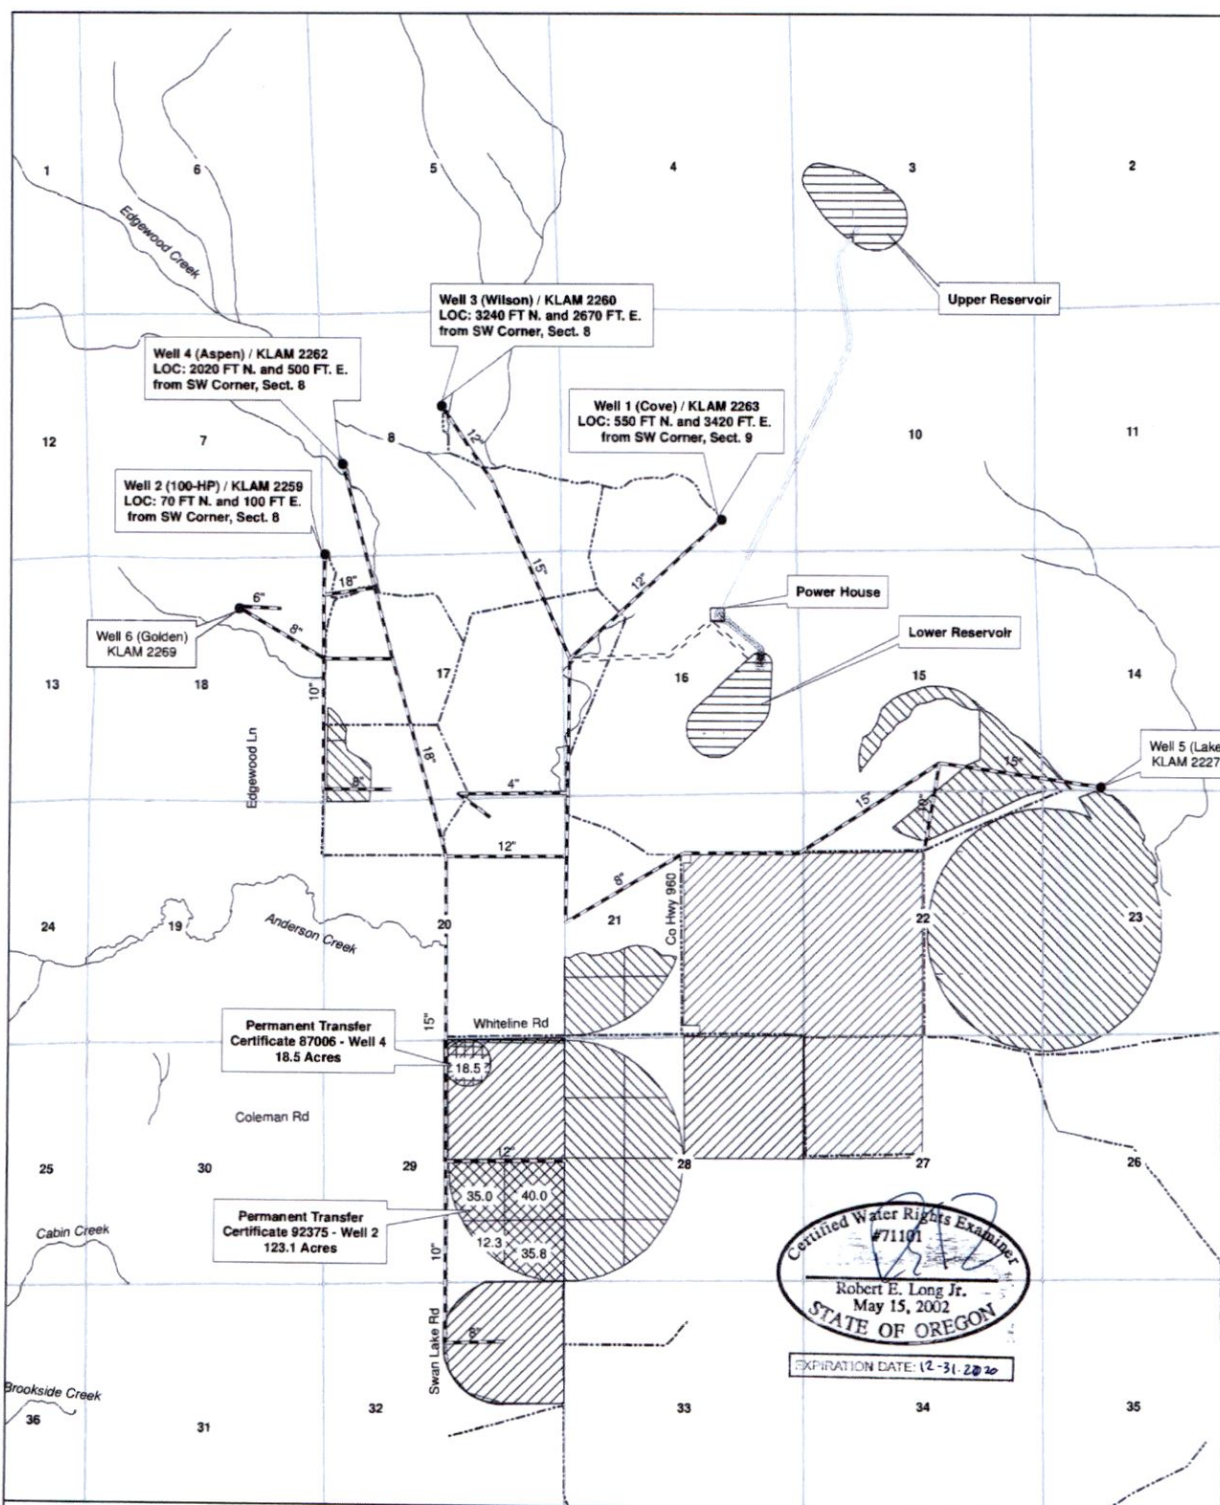

Legend

- Wells
- Ditch
- Existing Waterlines
- Proposed Penstock
- Stream
- Certificate 92375
- Transfer 123.1 AC from C92375
- Certificate 87006
- Transfer 18.5 AC from C87006
- Transfer To Swan Lake Hydro Project
- OR Public Land Survey
- Proposed Delivery Pipeline
- Roads



CWM-H2O
Complete Water Management


1319 SE MLK JR BLVD #204
Portland, OR 97214
503-954-1326

Swan Lake North Pumped Storage Project
12941 Swan Lake Rd
Klamath Falls, OR 97603

2,640 1,320 0 2,640 Feet
1 inch = 2,640 feet



Edgewood Ranch Certificates 92375 and 87006
Permanent Transfer - 141.6 Acres
Water System Overview
Oct. 29, 2019

This map not intended to provide legal
dimensions or property ownership lines

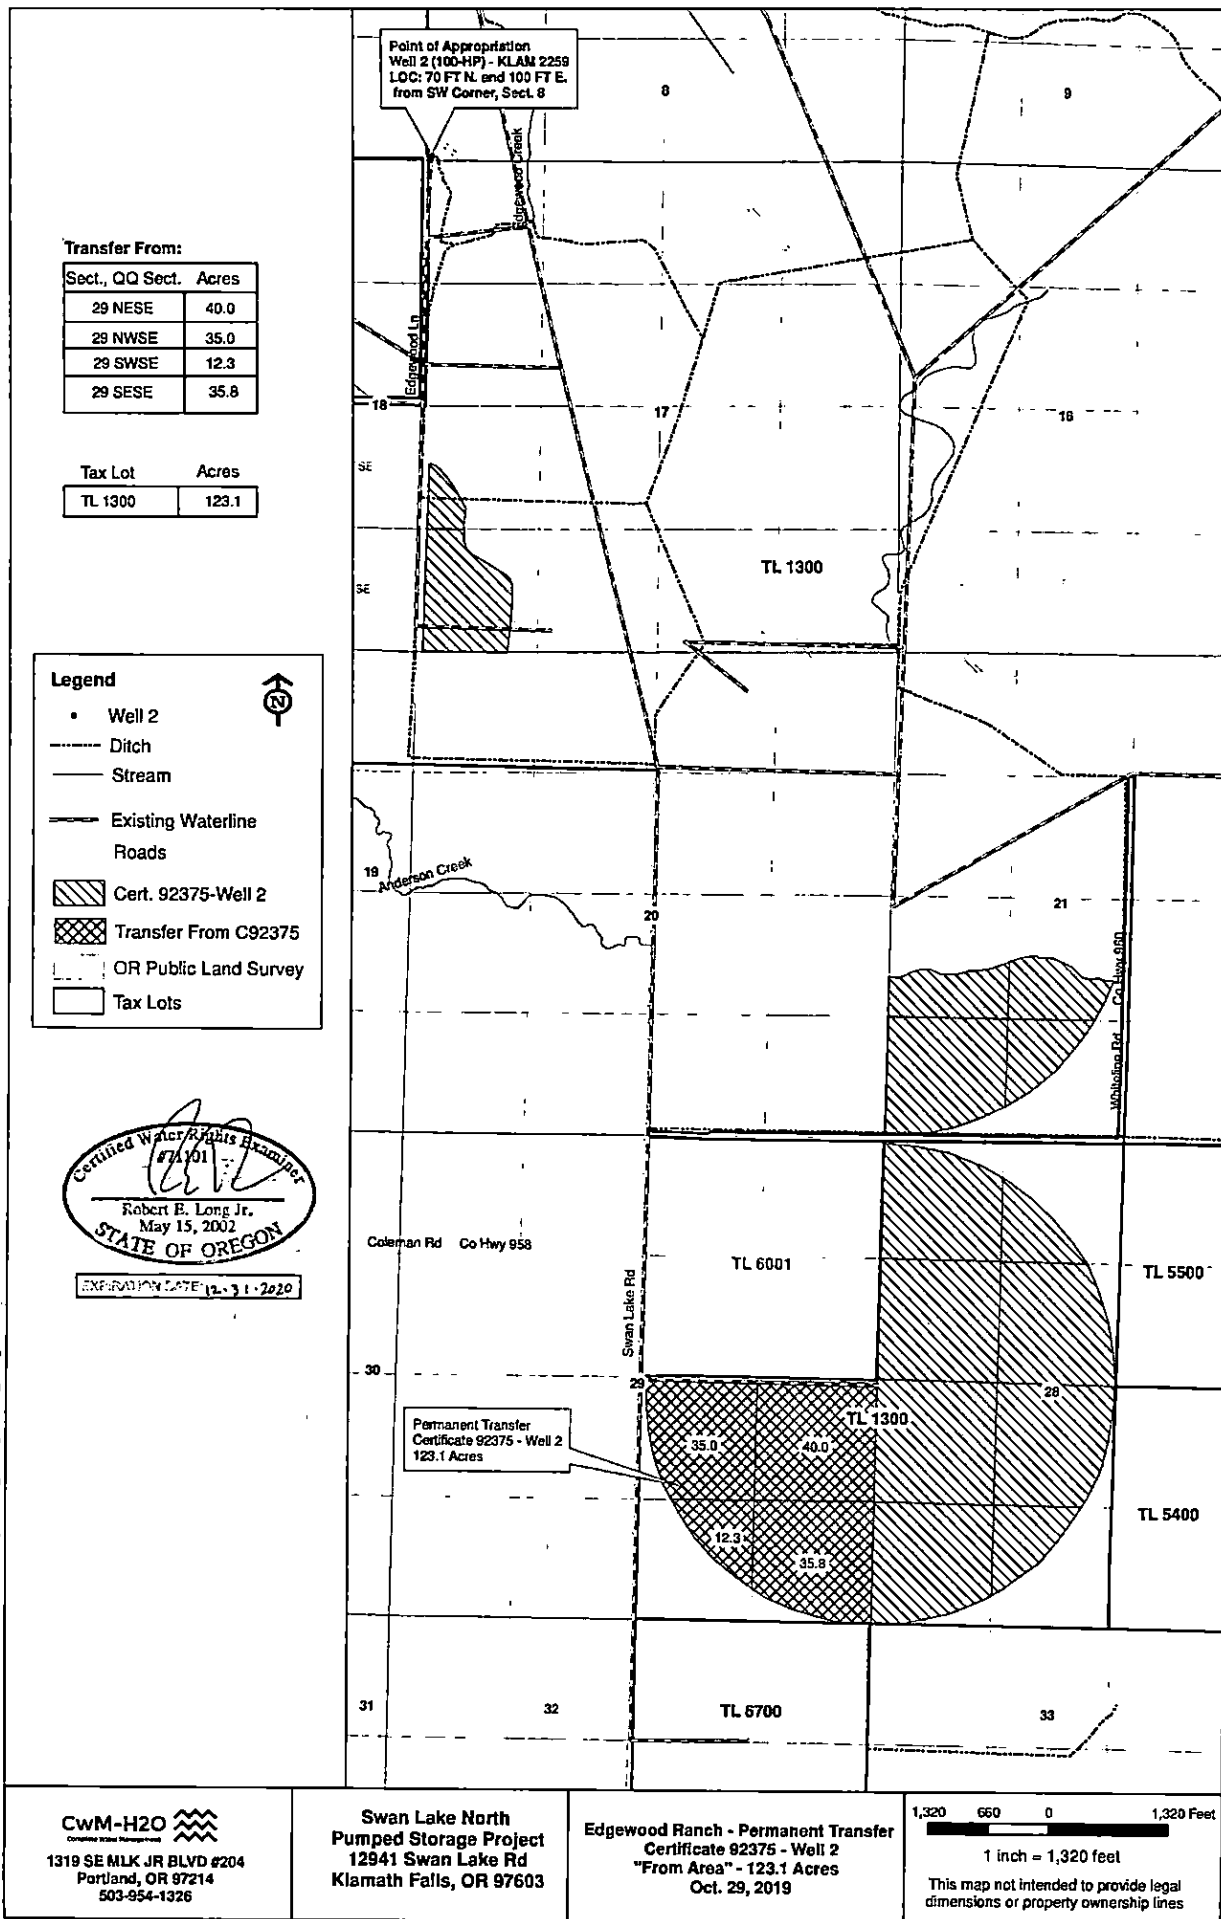

Point of Appropriation (POA) - Well 4

Additional POA - Well 3

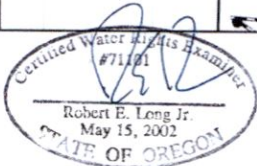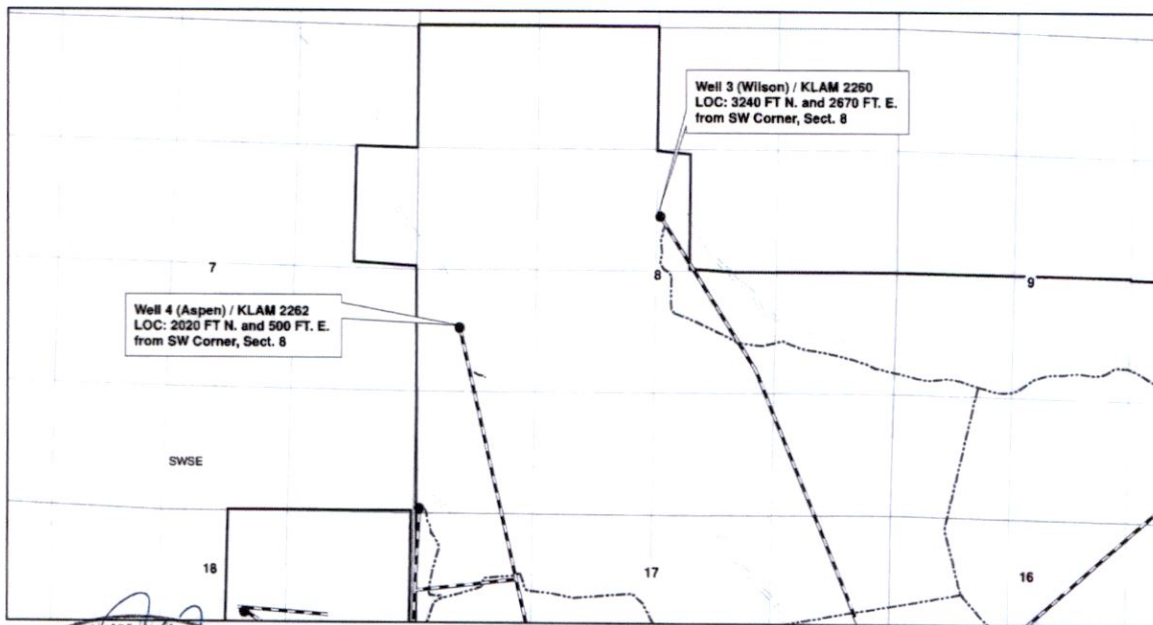

12-31-2020

Transfer From:

Sect., QQ Sect.	Acres
29 NWNE	18.5



Tax Lot	Acres
TL 6001	18.5

Legend

- Wells
- Ditch
- Stream
- Existing Waterline
- Roads
- Cert. 87006 - Well 4
- Transfer From 87006
- OR Public Land Survey
- Tax Lots



"From Area" Transfer 18.5 AC From Certificate 87006

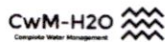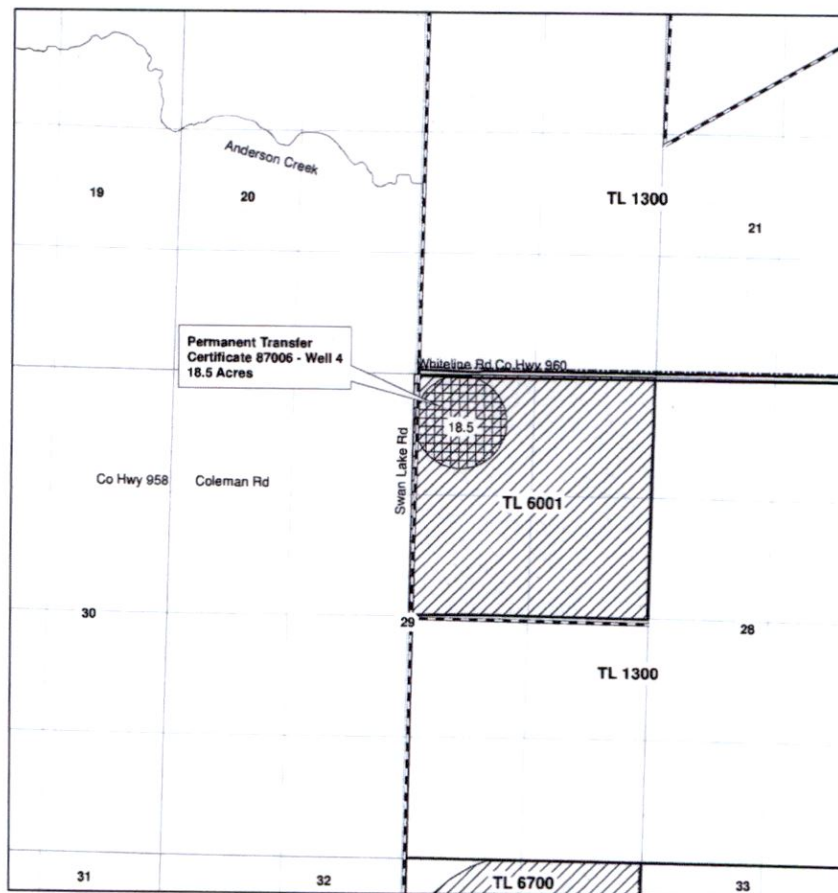

1319 SE MLK JR BLVD #204
Portland, OR 97214
503-954-1326

Swan Lake North
Pumped Storage Project
12941 Swan Lake Rd
Klamath Falls, OR 97603

Edgewood Ranch - Permanent Transfer
Certificate 87006
"From Area" - 18.5 Acres
Oct. 29, 2019

1,320 660 0 1,320 Feet

1 inch = 1,320 feet

This map not intended to provide legal
dimensions or property ownership lines

