


Section 7, T.4N., R.36E., W.M.
Umatilla County, Oregon

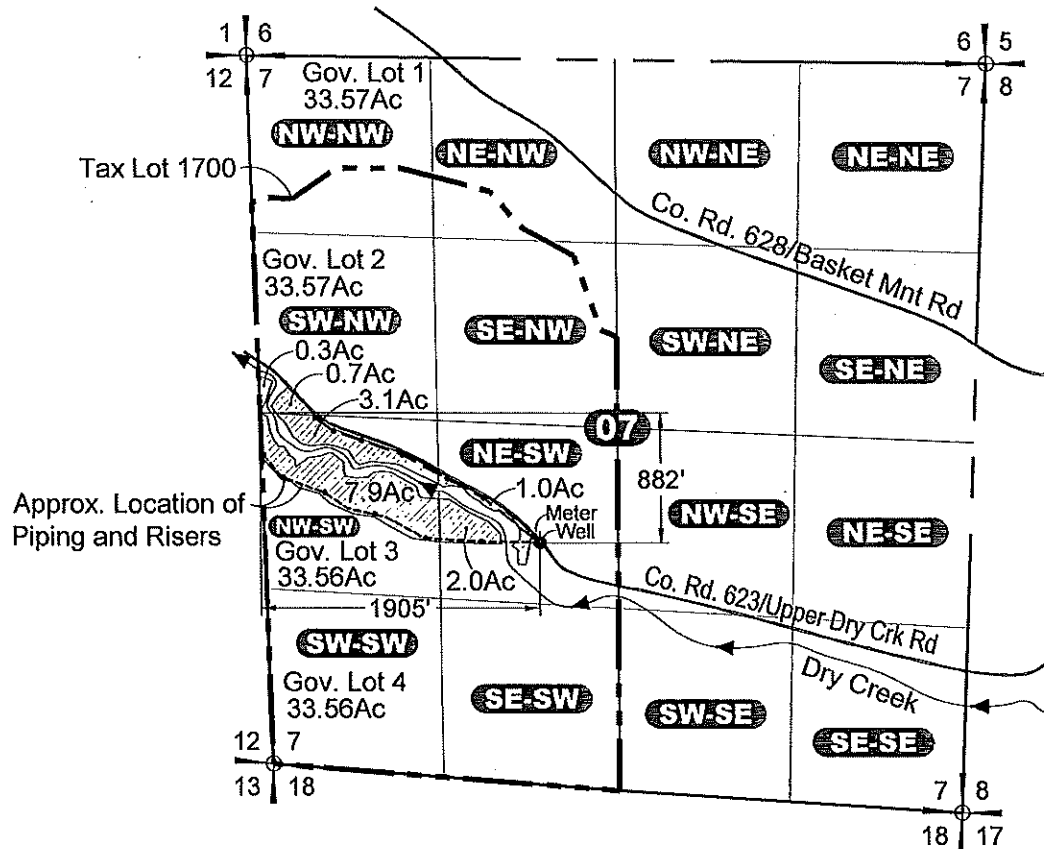


RECEIVED

OCT 15 2020

OWRD

LEGEND


- Irrigated Acres
- Location of Well
- Meter
- Riser
- Irrigation Piping
- Tax Lot Boundary

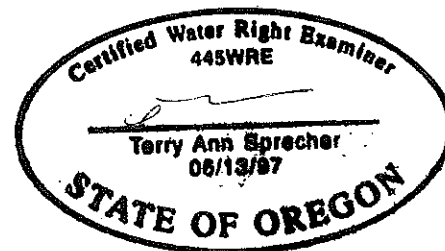

Expires 6/30/2022

NOTES

1. Meter Located 6' NW of Well House.
2. This map was prepared for the purpose of identifying the location of water rights only and is not intended to provide legal dimensions or locations of property ownership lines.
3. Base Map Sources:
 - GLO Map, 1876
 - Umatilla County Tax Lot Map 4N36

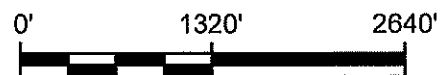

SCALE: 1" = 1320'
Approximately

Claim of Beneficial Use Map - Application G-15766, Permit G-15286
54462 Upper Dry Creek Rd
Weston, OR. 97886

CREATED BY: TAS/JF
DRAWN BY: SJS

Sprecher group
2445 NE Division St., Suite 300
Bend, Oregon 97703

SG PROJECT 4369
OCTOBER 2020