


**Claim of Beneficial Use
A Water Right in the Name of The Coquille Indian Tribe
Permit R-13908, Application R-85412**

RECEIVED

SEP 12 2019

Township 25 South, Range 13 and 14 West (W.M.)

OWRD

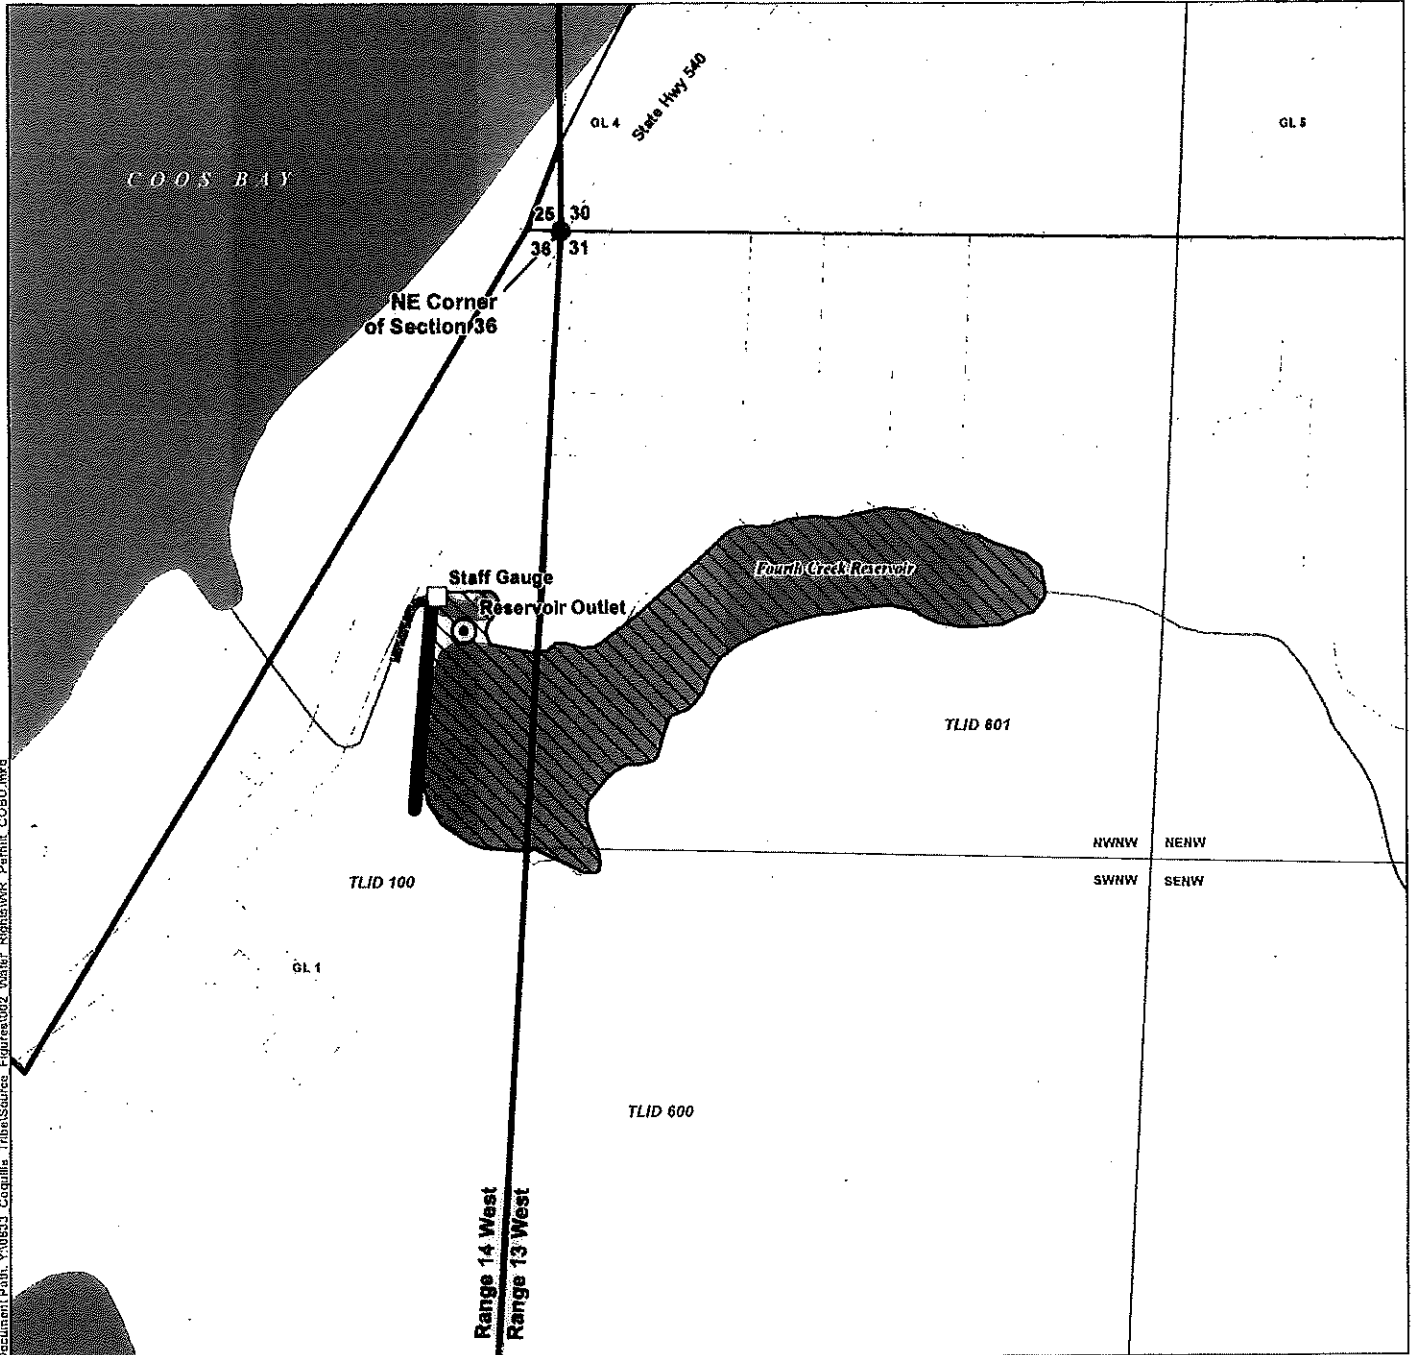

Document Path: Y:\0663_Coquille_TribalSource_Figures\02_Water_Rights\WR_Permit_COBU.mxd


LEGEND

- Point of Diversion (POD)
- Staff Gauge
- Place of Use (POU)
- Dam
- Fish By-Pass
- Spillway
- Government Lot (GL)
- All Other Features**
- Tax Lot
- Watercourse
- Waterbody

POD LOCATION DESCRIPTION

Point of Diversion Located 840 feet South and 155 feet West of the NE corner of Section 36, Township 25 South, Range 14 West (W.M.)

Certified Water Rights Examiner Stamp

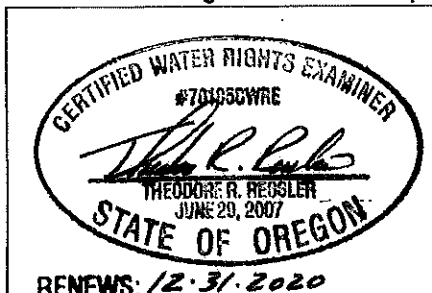

DISCLAIMER

This map was prepared for the purpose of identifying the location of a water right only and it is not intended to provide legal dimensions or location of property ownership lines.

MAP NOTES

Date: June 26, 2019
Data Sources: BLM, ESRI, Coos Co., USGS

