


T. 38 S., R. 1 W., W.M.

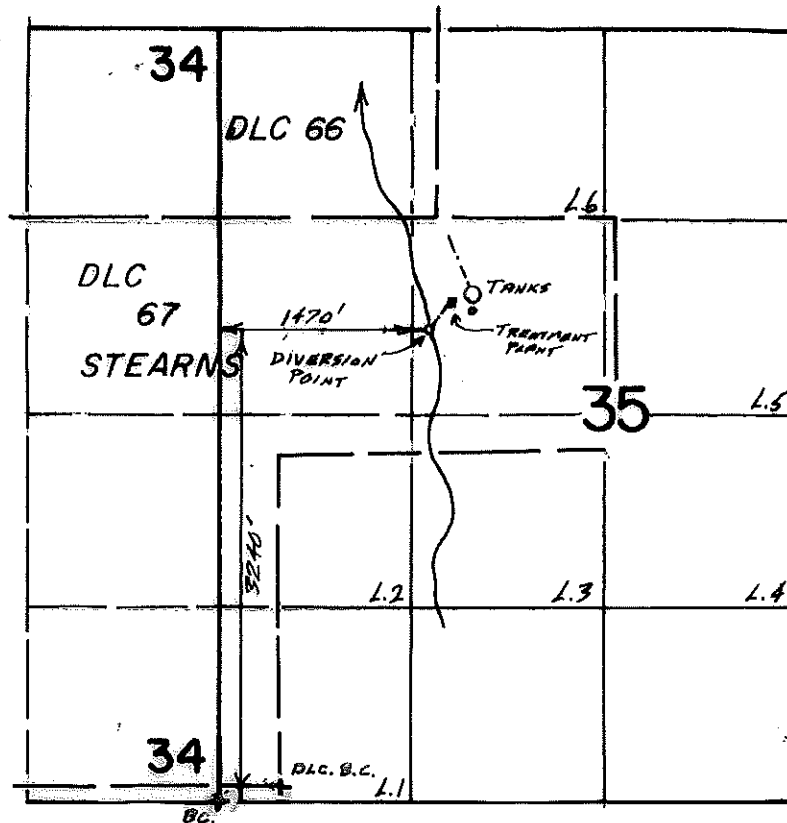

Scale 1" = 1320'

FINAL PROOF SURVEY
UNDER

Application No. 48137. Permit No. 36144....
IN NAME OF

CITY OF TALENT.....

Surveyed April 29, 1998, by B.S. DeHaas....

41029-179-222

7/98 BSD