


T.17S. R.2W. W.M.

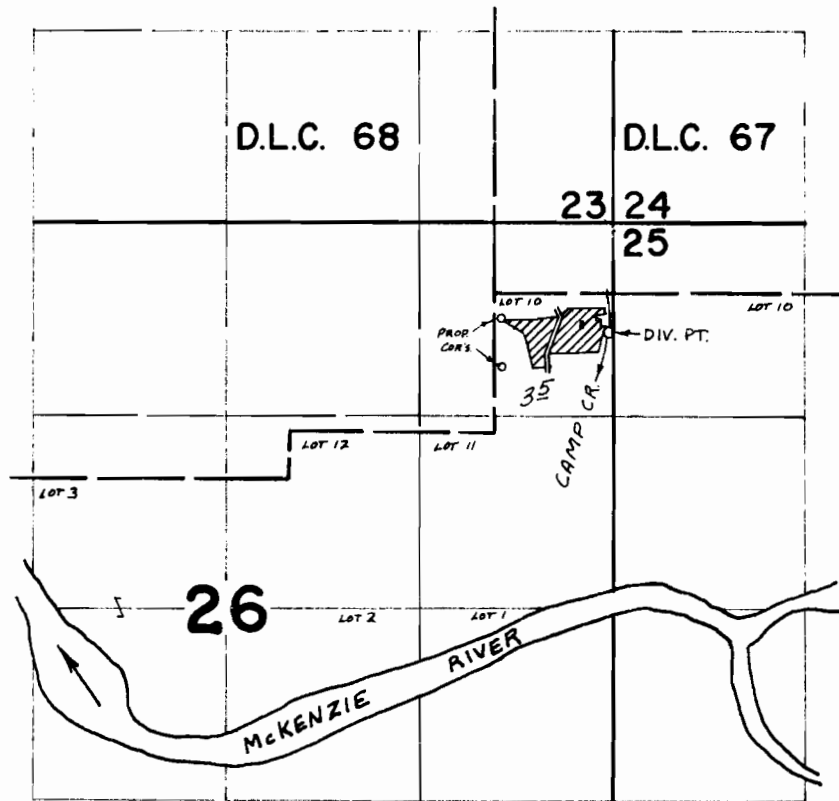

DIV. PT. LOCATED: 760'S + 30'W. FROM NE COR SEC. 26

REANOUS JESS COCHRAN

42720


31918

REANOUS JESS COCHRAN

JULY 8 75

L. TOLL

TOWNSHIP 17 SOUTH, RANGE 2 WEST, W.M.

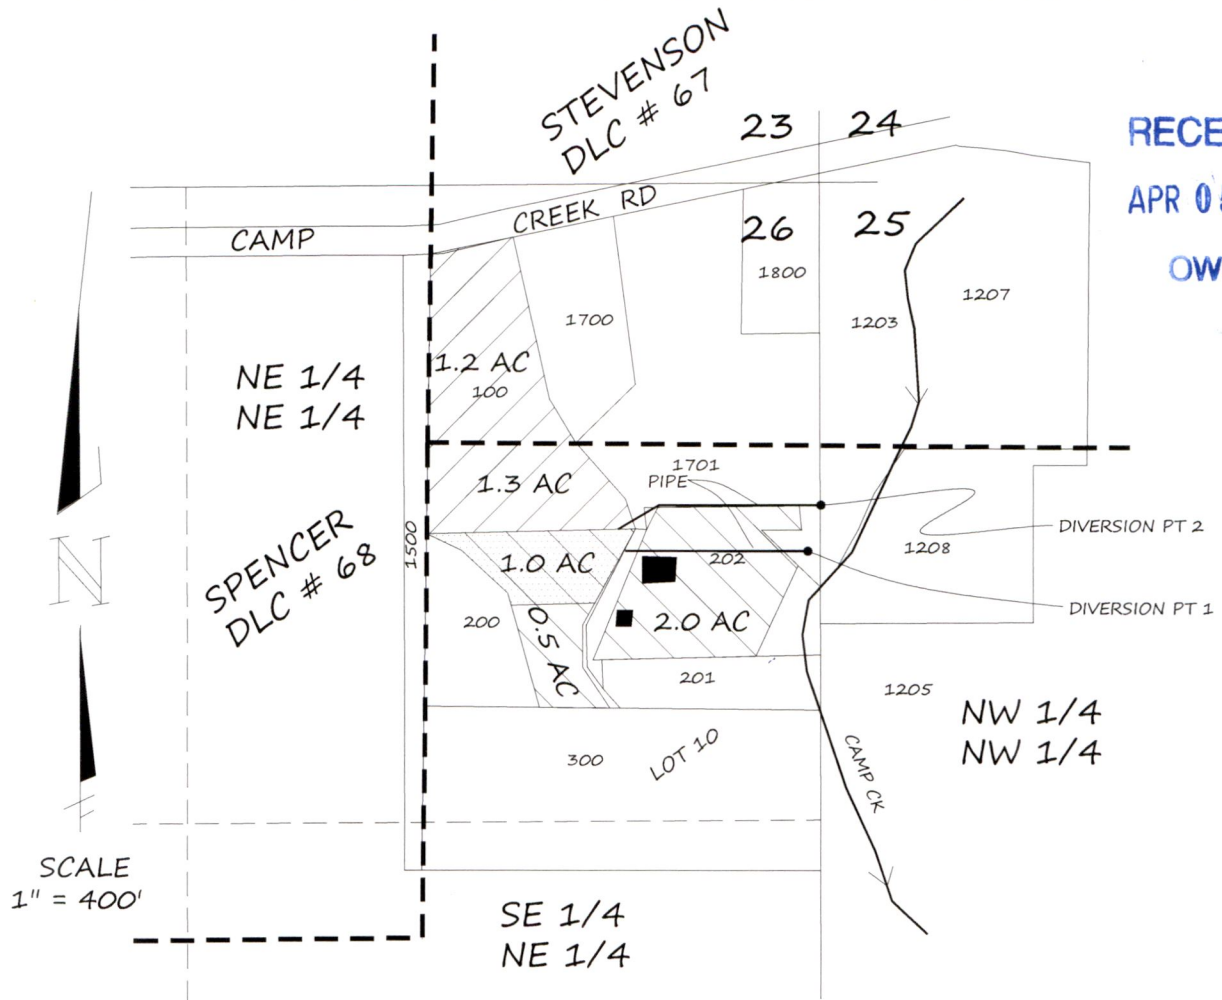

RECEIVED
APR 05 2023
OWRD

PROPOSED DIVERSION PT 2
666.9 FT SOUTH & 4 FT EAST
NE COR. SECTION 26

DIVERSION PT 1
760 FT SOUTH & 30 FT WEST
NE COR. SECTION 26



DENOTES AREA CERT. 28002



DENOTES AREA CERT. 44632



DENOTES AREA PROPOSED TRANSFER
FROM CERT 44632



DENOTES BUILDING LOCATION

ADDITIONAL POINT OF DIVERSION POINT MAP FOR


REANOUS & SANDRA COCHRAN
37276 CAMP CREEK ROAD
SPRINGFIELD, OR 97478

BY

H. TIMOTHY FASSBENDER, PLS, CWRE
2896 SARAH LANE
EUGENE, OR 97408
FEBURARY 15, 2023

NOTE:

THE PREPARATION OF THE MAP WAS
FOR THE PURPOSE OF IDENTIFYING THE
LOCATION OF THE WATER RIGHT ONLY.
IT IS NOT INTENDED TO PROVIDE
LOCATION NOR DIMENSIONS OF PROPERTY
OWNERSHIP LINES.

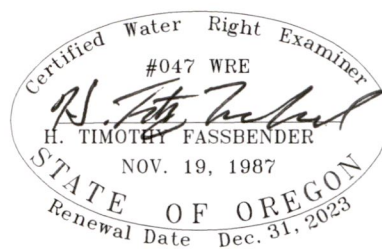

14210