


Certified Water Right Examiner
91134CWRE
MICHAEL HIGGINS
June 3, 2016
STATE OF OREGON
Expires: 6/30/2025

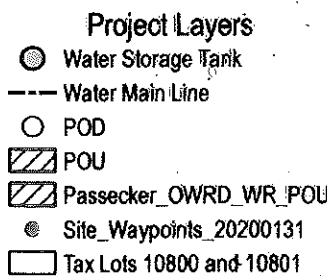

USGS - NHD-PLUS


NHD Flowline

- Ephemeral
- Intermittent
- Perennial

State Data - Boundaries

- Roads
- SEC
- PLS - QQ

DISC

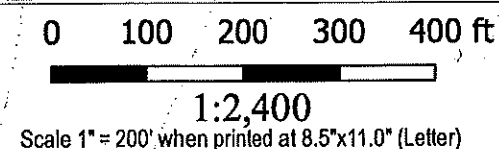

DISCLAIMER
This map was prepared for the purpose of identifying the location of water right only and is not intended to provide legal dimensions or location of property ownership lines.

Source:
Lincoln County
EPSG:6557 - NAD83(2011) / Oregon GIC Lambert (ft)
GIS Data: Oregon Geospatial, ORMAP, Lincoln County, USGS, DOGAMI

HGX Solutions, LLC.

Prepared By: Michael Higgins, CWRE Date: 5/30/2023

Passecker Surface Water Right - Claim of Beneficial Use Map
Final Proof Survey: Permit No. S-55137
Tax Map 12-11-19-C Tax Lots 10800 and 10801