



RECEIVED

SEP 26 2022

OWRD

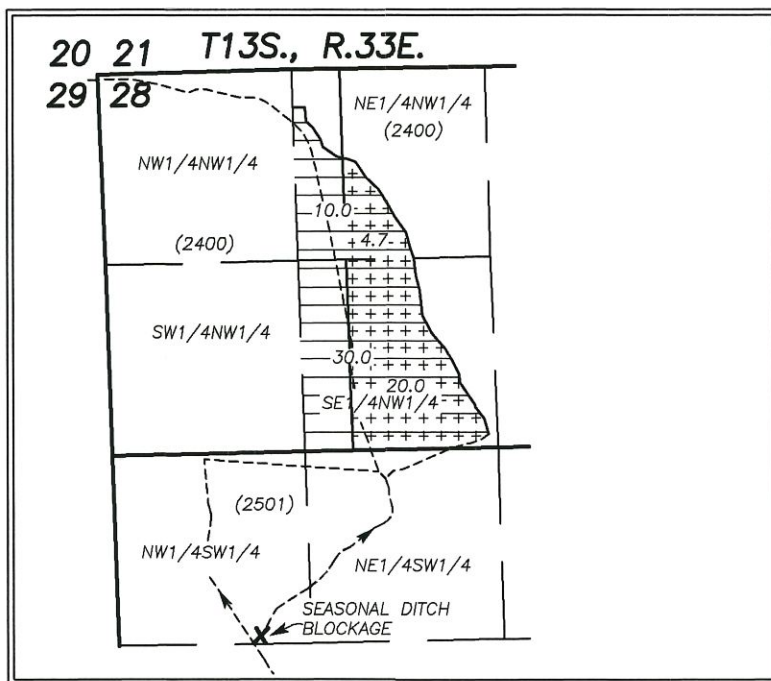

SCALE: 1" = 1320'

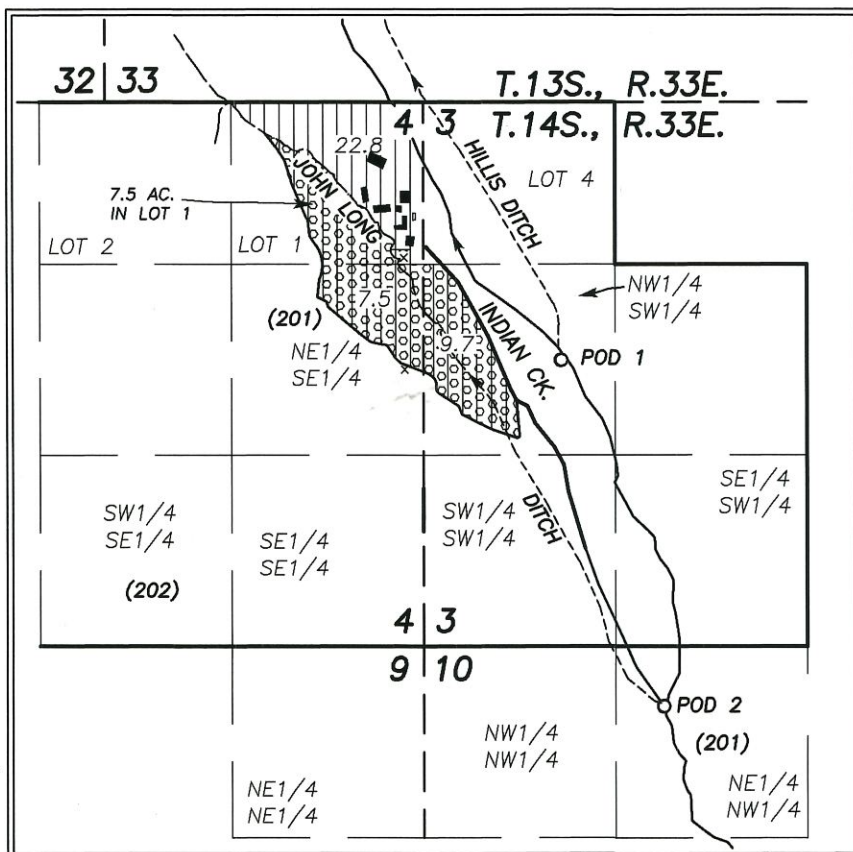

CLAIM OF BENEFICIAL USE MAP
UNDER
TRANSFER NO. T-10898
SPECIAL ORDER NO. 117-468
FOR
BLUE MOUNTAIN ANGUS, LLC

PREPARED BY:
ROBERT D. BAGETT, PLS, CWRE
217 N. CANYON BLVD.
JOHN DAY, OREGON
(541) 575-1251

SEPTEMBER 3, 2022

AUTHORIZED POD'S AS LOCATED MAY 11, 2009

- POD#1: 7070' SOUTH & 3130' EAST FROM THE NW COR. SEC. 33, T.13S., R.33E.
ODFW FISH SCREEN & FISH BYPASS STRUCTURE BEARS N.7°W., 72 FT.
MEASURING DEVICE, BEARS N.20°W., 295 FT.
- POD#2: 9450' SOUTH & 3850' EAST FROM THE NW COR. SEC. 33, T.13S., R.33E.
ODFW FISH SCREEN & FISH BYPASS STRUCTURE BEARS N.16°W., 150 FT.
MEASURING DEVICE, BEARS N.16°W., 190 FT.


X SEASONAL DITCH BLOCKAGE: 1330' NORTH & 1010' EAST FROM NW COR. SECTION 33, T.13S., R.33E., W.M.

- POD #1**
PRIMARY
- SUPPLEMENTAL
- POD #2**
PRIMARY
- SUPPLEMENTAL

----- DITCH

() TAX LOT NO.

FOUND BRASS CAP MONUMENT AT THE NW
CORNER SECTION 33, T.13S., R.33E., W.M.

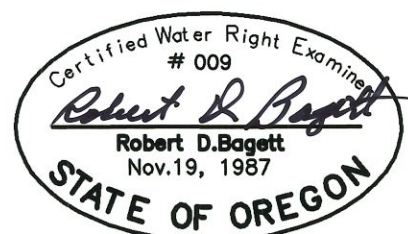

RENEWES 12/31/2023

DISCLAIMER: THIS MAP IS NOT INTENDED TO PROVIDE LEGAL
DIMENSIONS OR LOCATIONS OF PROPERTY OWNERSHIP LINES.