


Permanent APOD Map

RECEIVED


JUL 26 2021

OWRD

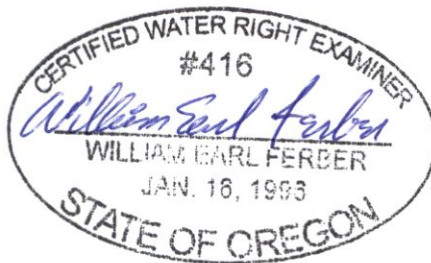

T.4S., R.3W., W.M.

EXPIRES: Dec. 31, 2021

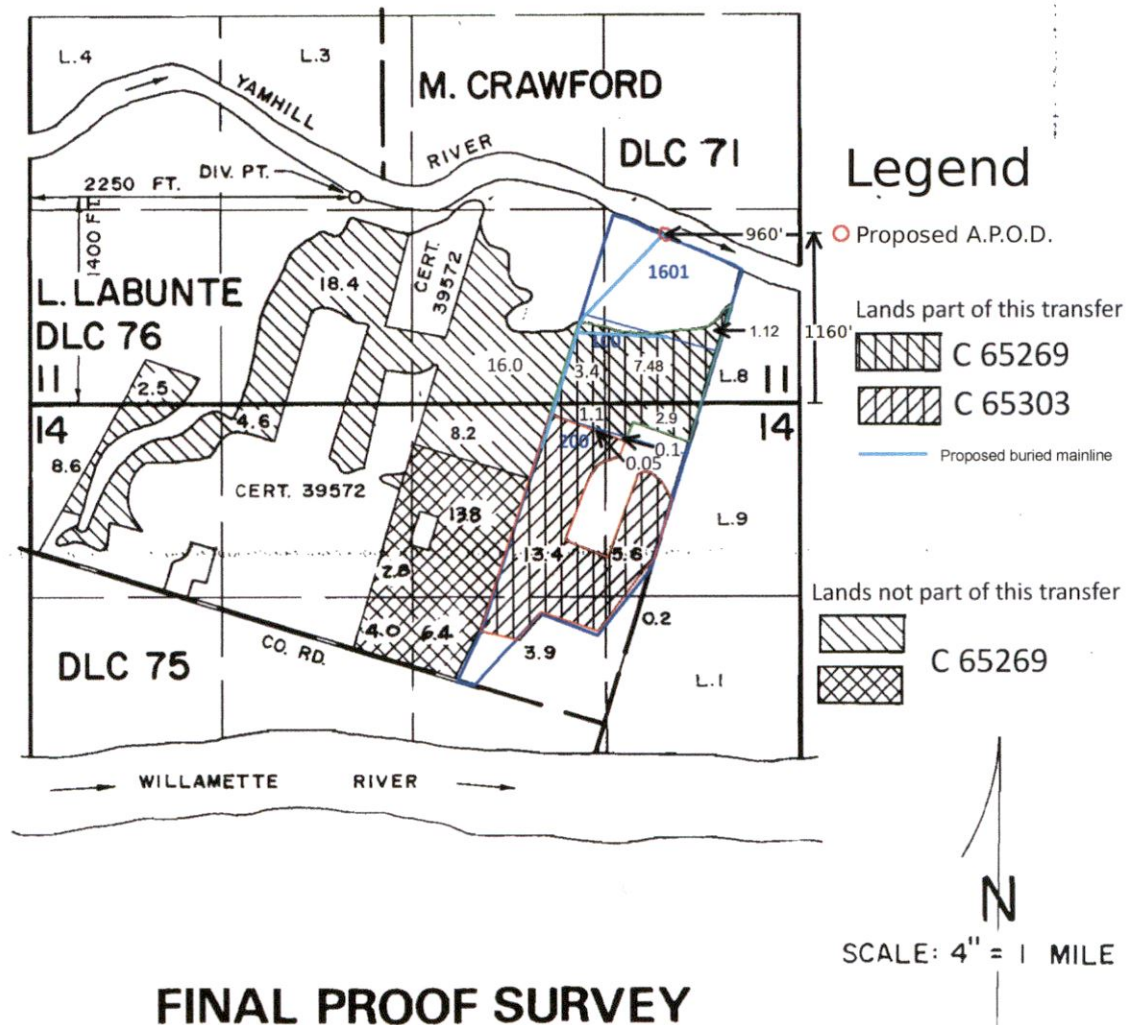

FINAL PROOF SURVEY UNDER


Application No. 58637 44208
53310 Permit No. 39730
IN NAME OF

GARY L. OWENS

Surveyed MAY 31, 1984, by P. Pagten

13781

Permanent Change in Character of Use Map - from Irrigation to Livestock and Livestock Cooling

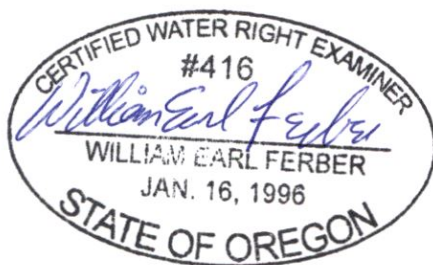

EXPIRES: Dec. 31, 2021

T.4S., R.3W., W.M.

RECEIVED

JUL 26 2021

OWRD Legend

Lands part of
this transfer

 Certificate 65269

Lands not part of
this transfer


Certificate 65269

PRIMARY



SUPPLEMENTAL

Certificate 65303

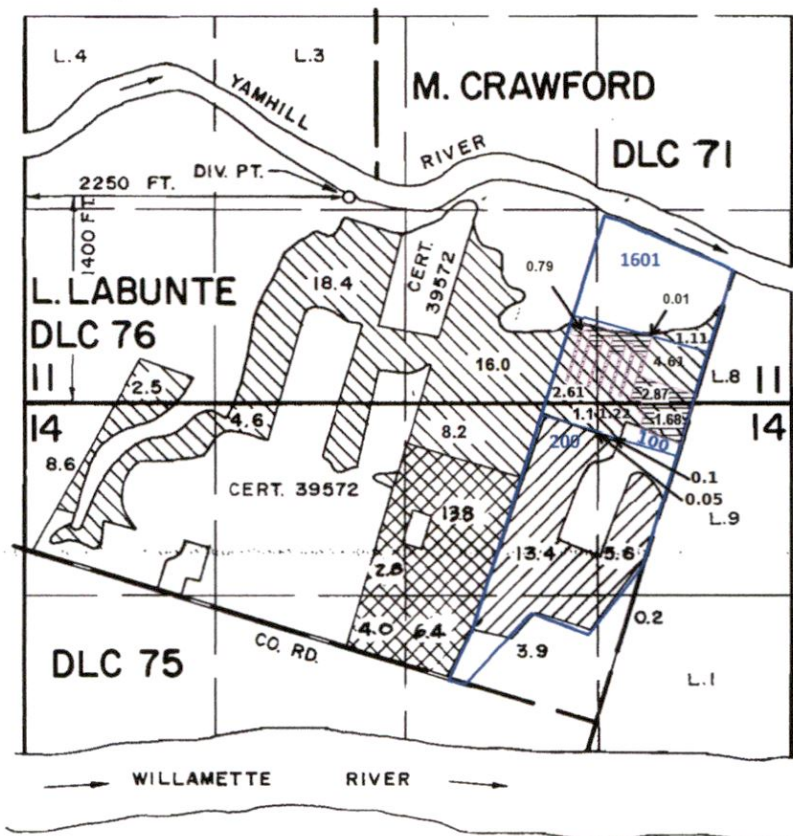

N
SCALE: 4" = 1 MILE

FINAL PROOF SURVEY

UNDER

Application No. 58637 44208
53310 Permit No. 39730
IN NAME OF

GARY L. OWENS


Surveyed MAY 31, 1984, by P. Paster

13781

4 3 14

CANCELLED
300
107
200
107

THIS MAP WAS PREPARED FOR
ASSESSMENT PURPOSE ONLY

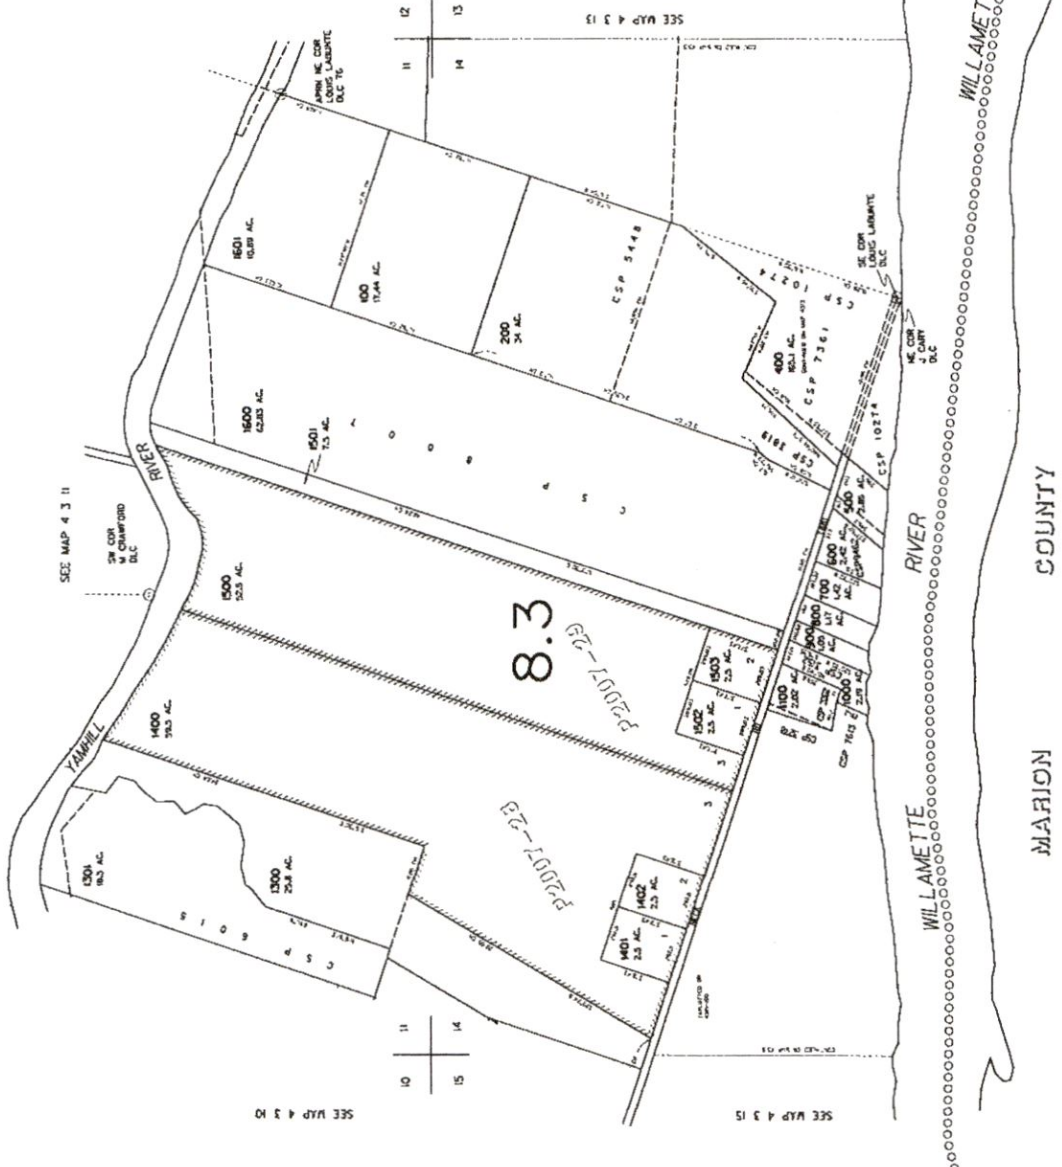

434


RECEIVED

JUL 26 2021

OWRD

13781

T.4S., R.3W., W.M.

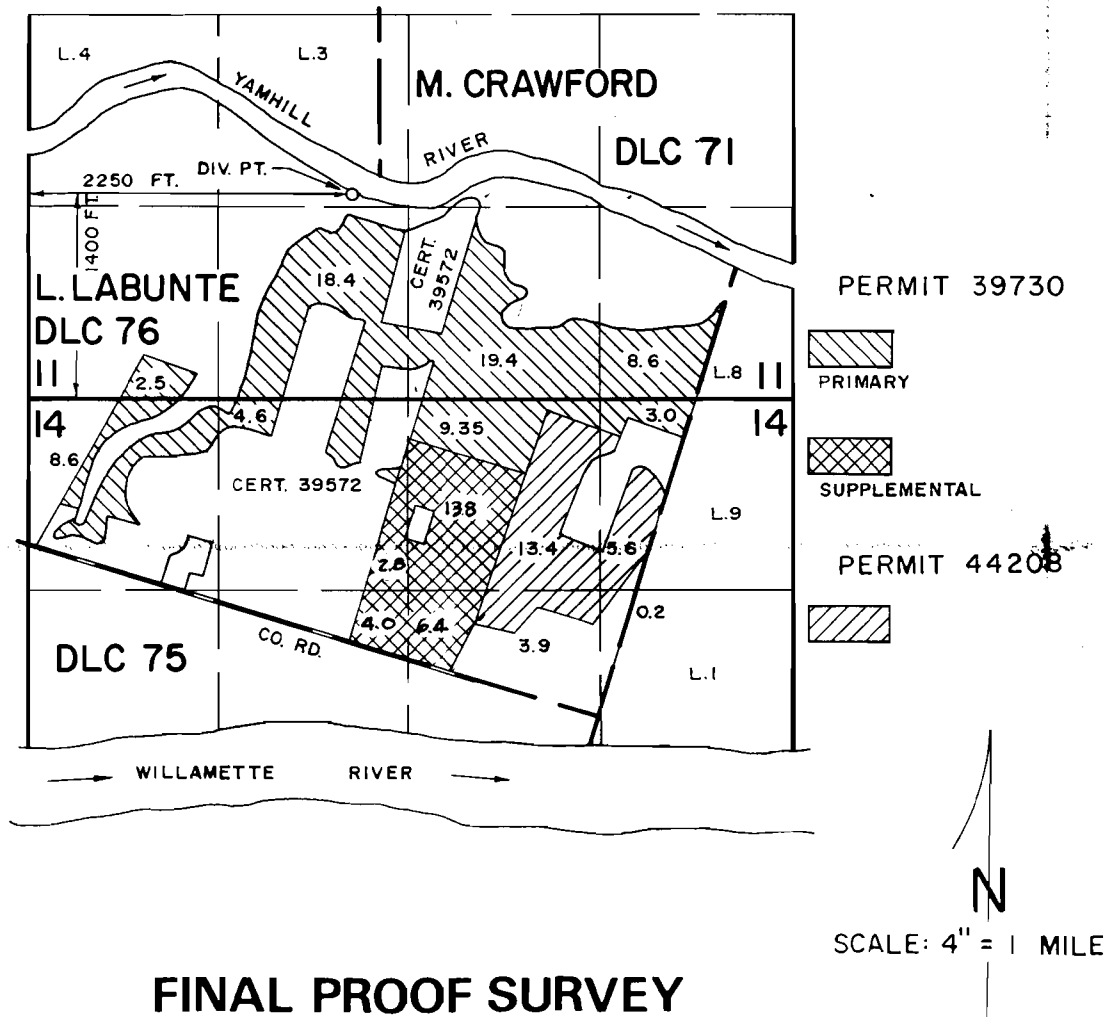

FINAL PROOF SURVEY UNDER

Application No. 58637 Permit No. 44208
53310 39730
IN NAME OF

GARY L. OWENS

Surveyed MAY 31, 1984, by P. P. Patten