


G-6654
54425


T. 25 S., R. 15 E., W.M.

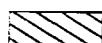

WELL #2



WELL #1

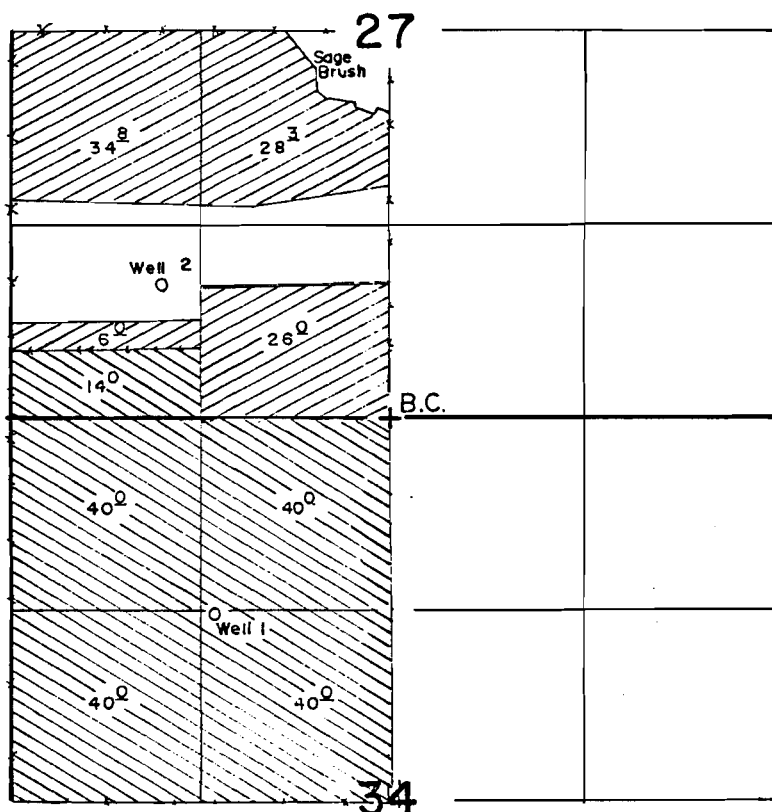

Well 1 Loc.: 1340' S. & 1200' W. from the N 1/4 Cor. Sec. 34

Well 2 Loc.: 900' N & 1580' W. from the N 1/4 Cor. Sec. 34

FINAL PROOF SURVEY UNDER

G- 8672

G-8097 (Cont 54427)

Application No. G-7254 Permit No. G-6654

IN NAME OF

GEORGE H. WARMINGTON

Surveyed OCT. 20, 1983, by L. TOLL



E-RECEIVED

September 24, 2024

OWRD

REVISED

T25S R15E, WM,
LAKE COUNTY, OR

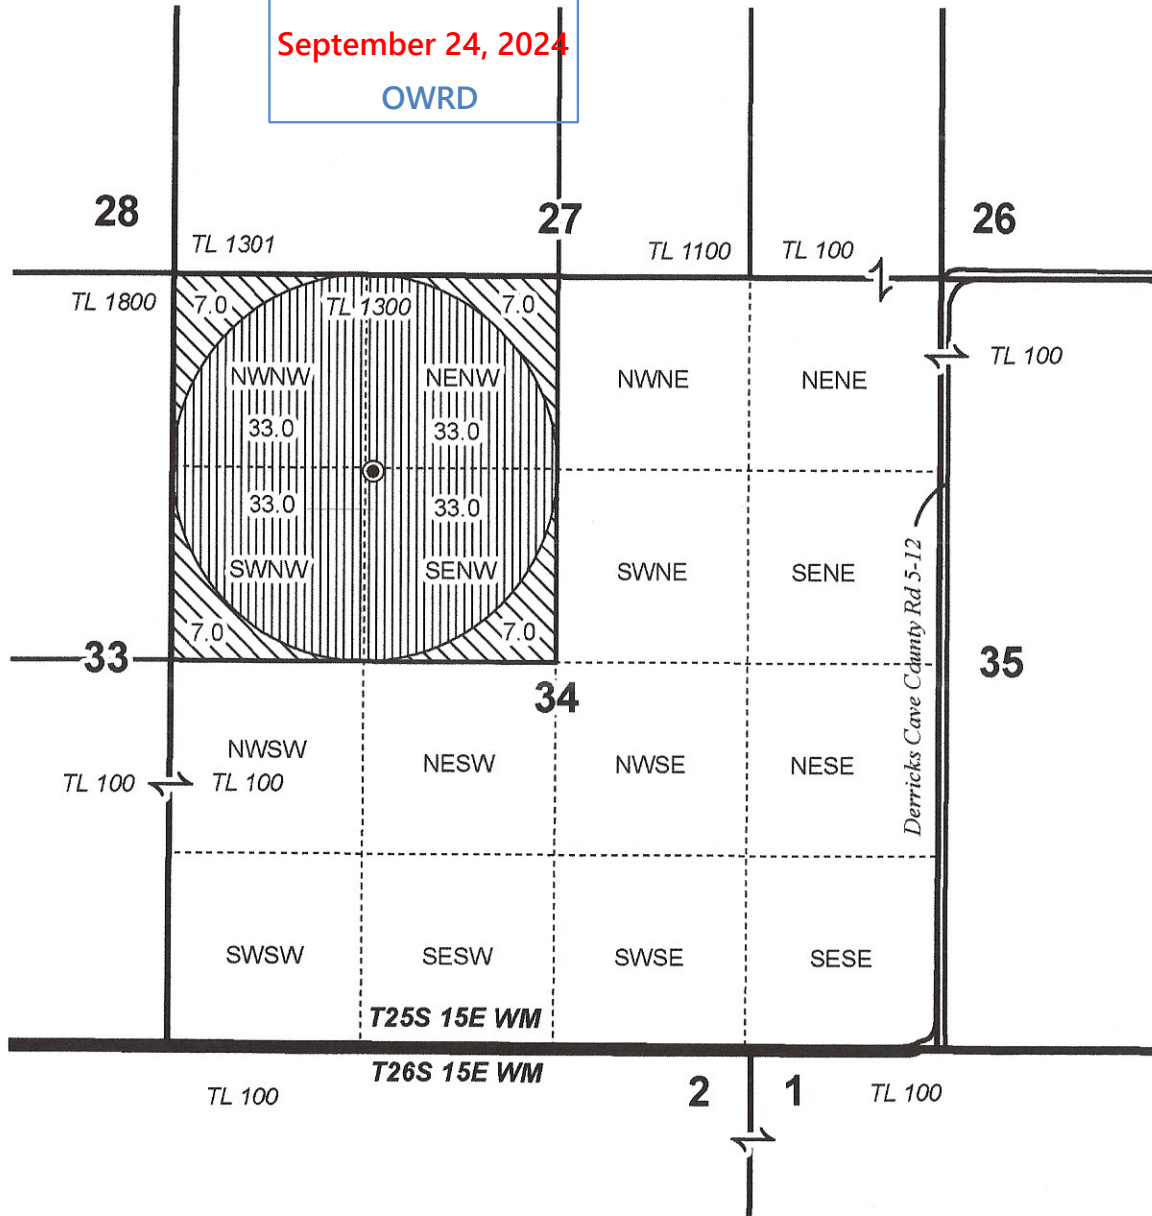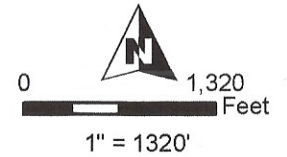

- Well
- POU IR C-54425 Priority 2-9-1976 "ON"
- POU IR C-54425 Priority 2-9-1976 "OFF"
- POU IR C-54425 Priority 2-9-1976 "NO CHANGE"
- Township
- Section
- Quarter Quarter
- Tax Lot

Well Location (LAKE 190): 1340' S, 1200' W of N 1/4 Cor Sec 34



PERMANENT TRANSFER "OFF" MAP
Borror Ranch

Date: 9/24/2024

C-54425 "OFF"

This map is not intended
to provide legal dimensions
or locations of property
ownership lines.

WATER RIGHT SERVICES, LLC
PO BOX 1830, BEND, OR 97709
WWW.OREGONWATER.US 541-389-2837
johnshort@usa.com CCB # 197121