

SHARON FERLITA
WE GROW OREGON LLC
15148 SHILOH ROAD
WHITE CITY, OR 97503

APPLICATION NO. G-18441


PERMIT NO. G-17945

SITUATED IN
SECTION 12, TOWNSHIP 35 S
RANGE 2 W, W.M.
JACKSON COUNTY OREGON

LEGEND

● WELL #1 JACK-61311
955' NORTH and 195' EAST
OF SOUTHWEST CORNER
SECTION 12, T35S R 2W

▨ PRIMARY IRRIGATION
16.5 ACS

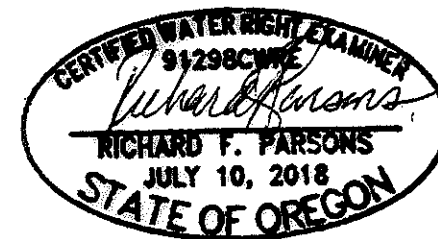

RECEIVED

MAY 13 2022

OWRD

RECEIVED

JUL 21 2022

OWRD

11

SESE

SHILOH ROAD

BEAGLE ROAD

14

NENE

SW CORNER
SECTION 12

T35S R02W

NWNW 13

TL 500

SESW

NENW

12

SWSW

JACK 61311

Constance Cr



0 135 270 ft

This map is not intended to provide
legal dimensions or locations of
property ownership lines

ParsonsWater Consulting LLC
rick.parsons@parsonwater.com
541.499.0257 303.667.5067