



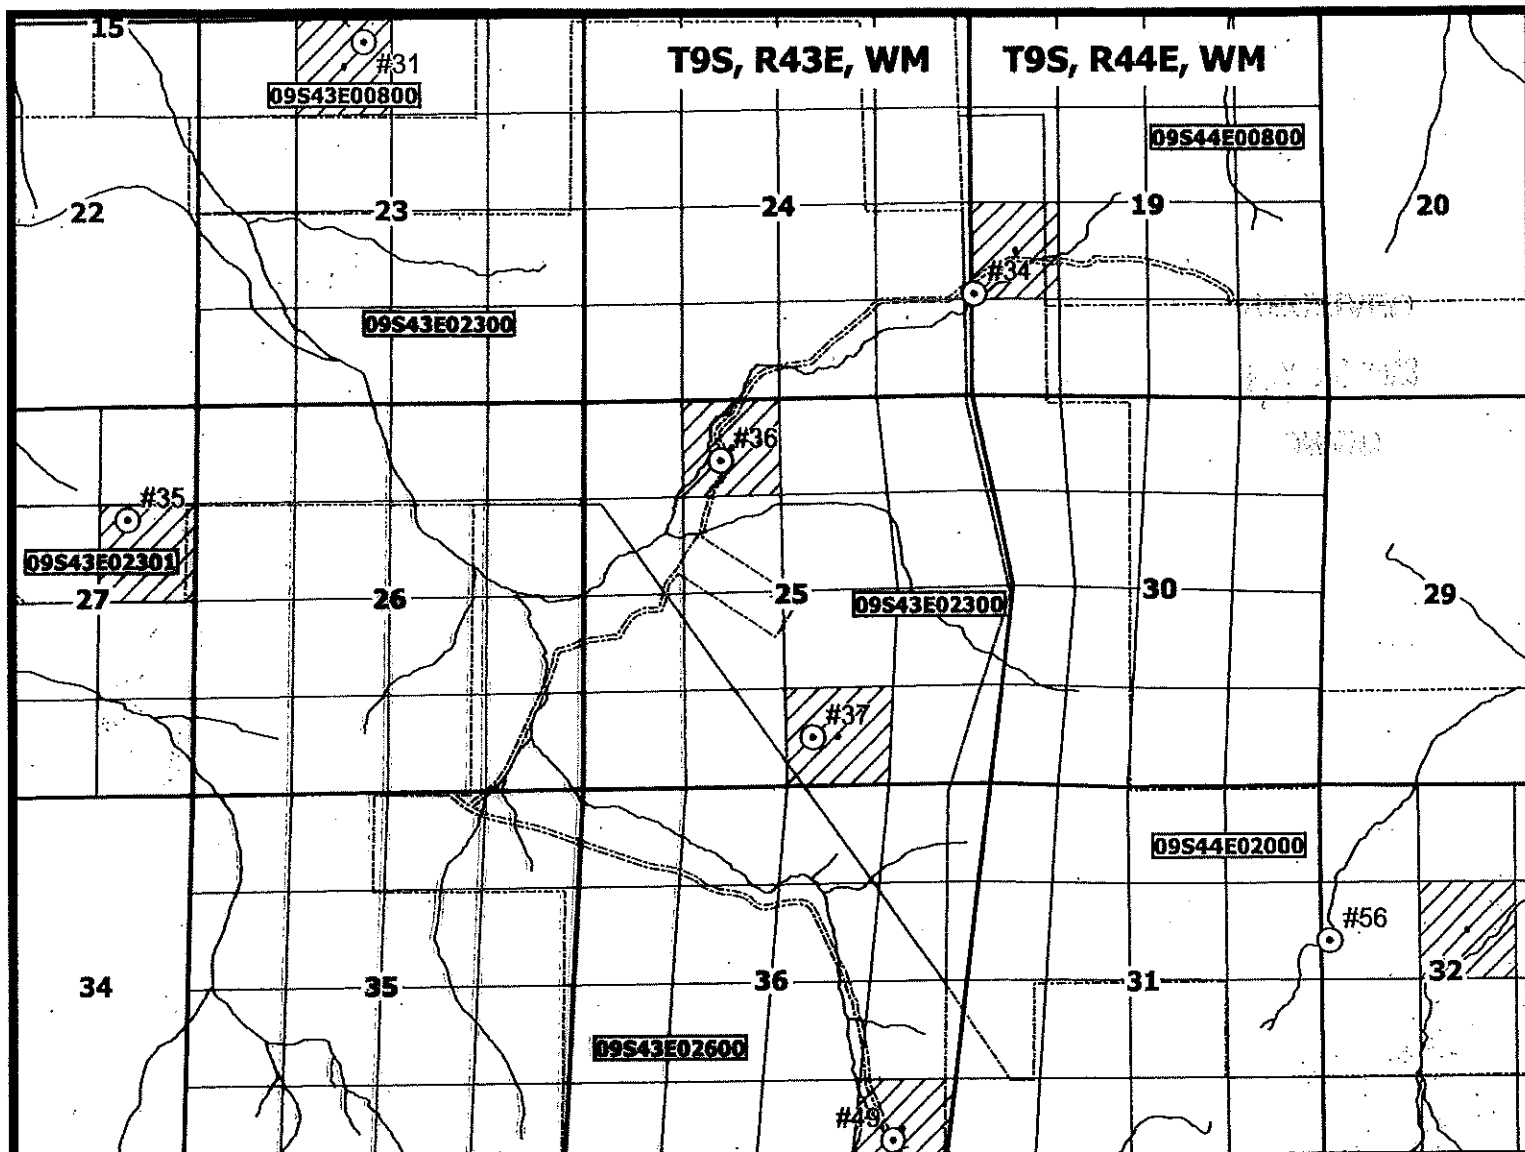

LEGEND

- ⊙ Point of Diversion
- ▨ Permitted Place of Use
- Baker County Taxlot Boundary (Maptaxlot number shown)

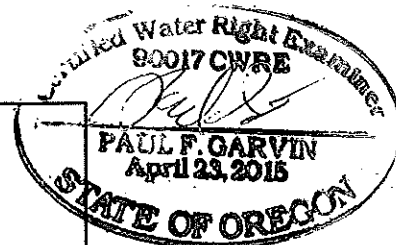

Claim of Beneficial Use Map Application S-71215, Permit S-52470 Baker County, OR

Prepared on behalf of Fred Phillips

1 inch = 0.5 mile




Notes:

Spring #31: 2,300' E and 300' S from the NW Corner of Section 23
 Spring #35: 925' W and 1,570' S from the NE Corner of Section 27
 Spring #36: 1,855' E and 800' S from the NE Corner of Section 25
 Spring #37: 275' W and 650' N from the SE Corner of Section 25
 Spring #49: 720' W and 512' N from the SE Corner of Section 36
 Spring #34: 35' E and 1,385' N from the SW Corner of Section 19
 Spring #56: 125' E and 2,130' S from the NW Corner of Section 32


This map is not intended to provide legal dimensions or locations of property ownership lines.

The Powder River (source) is located approximately 3 miles north Spring #31

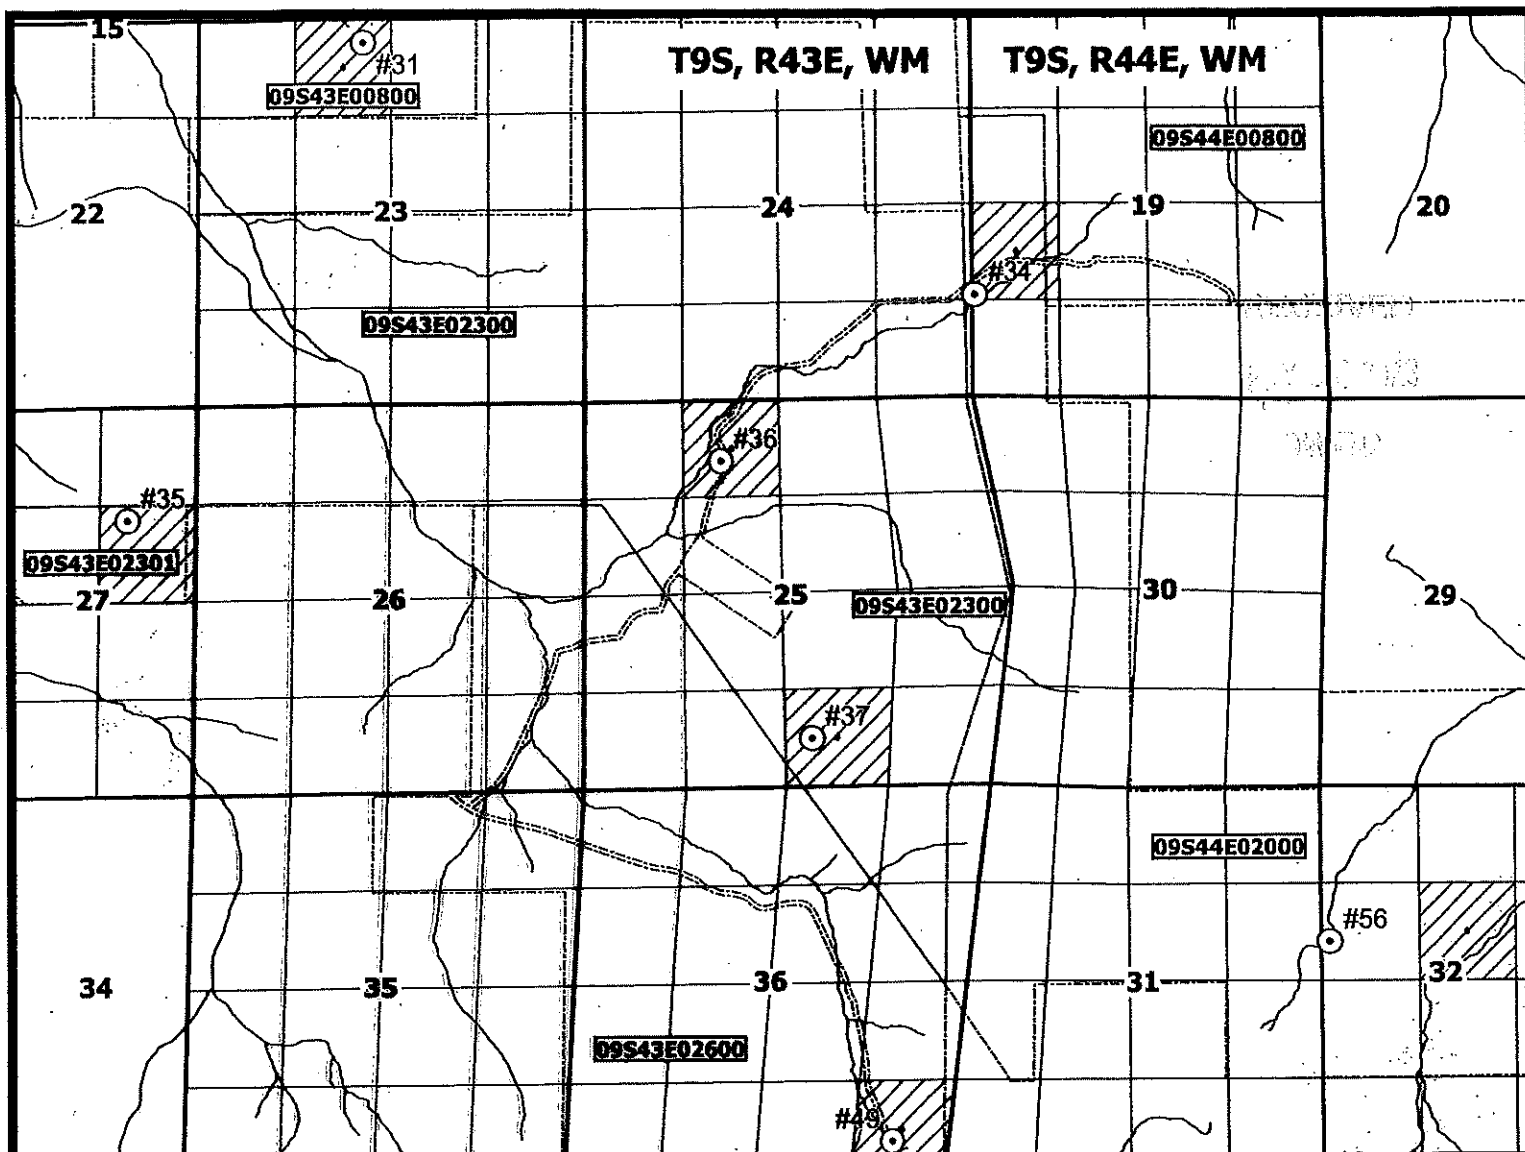

LEGEND

- Point of Diversion
- ▨ Permitted Place of Use
- Baker County Taxlot Boundary (Maptaxlot number shown)

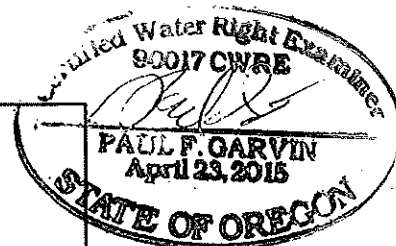


Claim of Beneficial Use Map Application S-71215, Permit S-52470 Baker County, OR

Prepared on behalf of Fred Phillips

1 inch = 0.5 mile



Notes:

Spring #31: 2,300' E and 300' S from the NW Corner of Section 23
Spring #35: 925' W and 1,570' S from the NE Corner of Section 27
Spring #36: 1,855' E and 800' S from the NE Corner of Section 25
Spring #37: 275' W and 650' N from the SE Corner of Section 25
Spring #49: 720' W and 512' N from the SE Corner of Section 36
Spring #34: 35' E and 1,385' N from the SW Corner of Section 19
Spring #56: 125' E and 2,130' S from the NW Corner of Section 32

This map is not intended to provide legal dimensions or locations of property ownership lines.

The Powder River (source) is located approximately 3 miles north Spring #31