


Paradise Lodge, LLC
Claim of Beneficial Use Map
Application S-87036 Permit S-54550

T 33 S, R 10 & 11 W
 Sections 18 & 25

Page 1 of 2

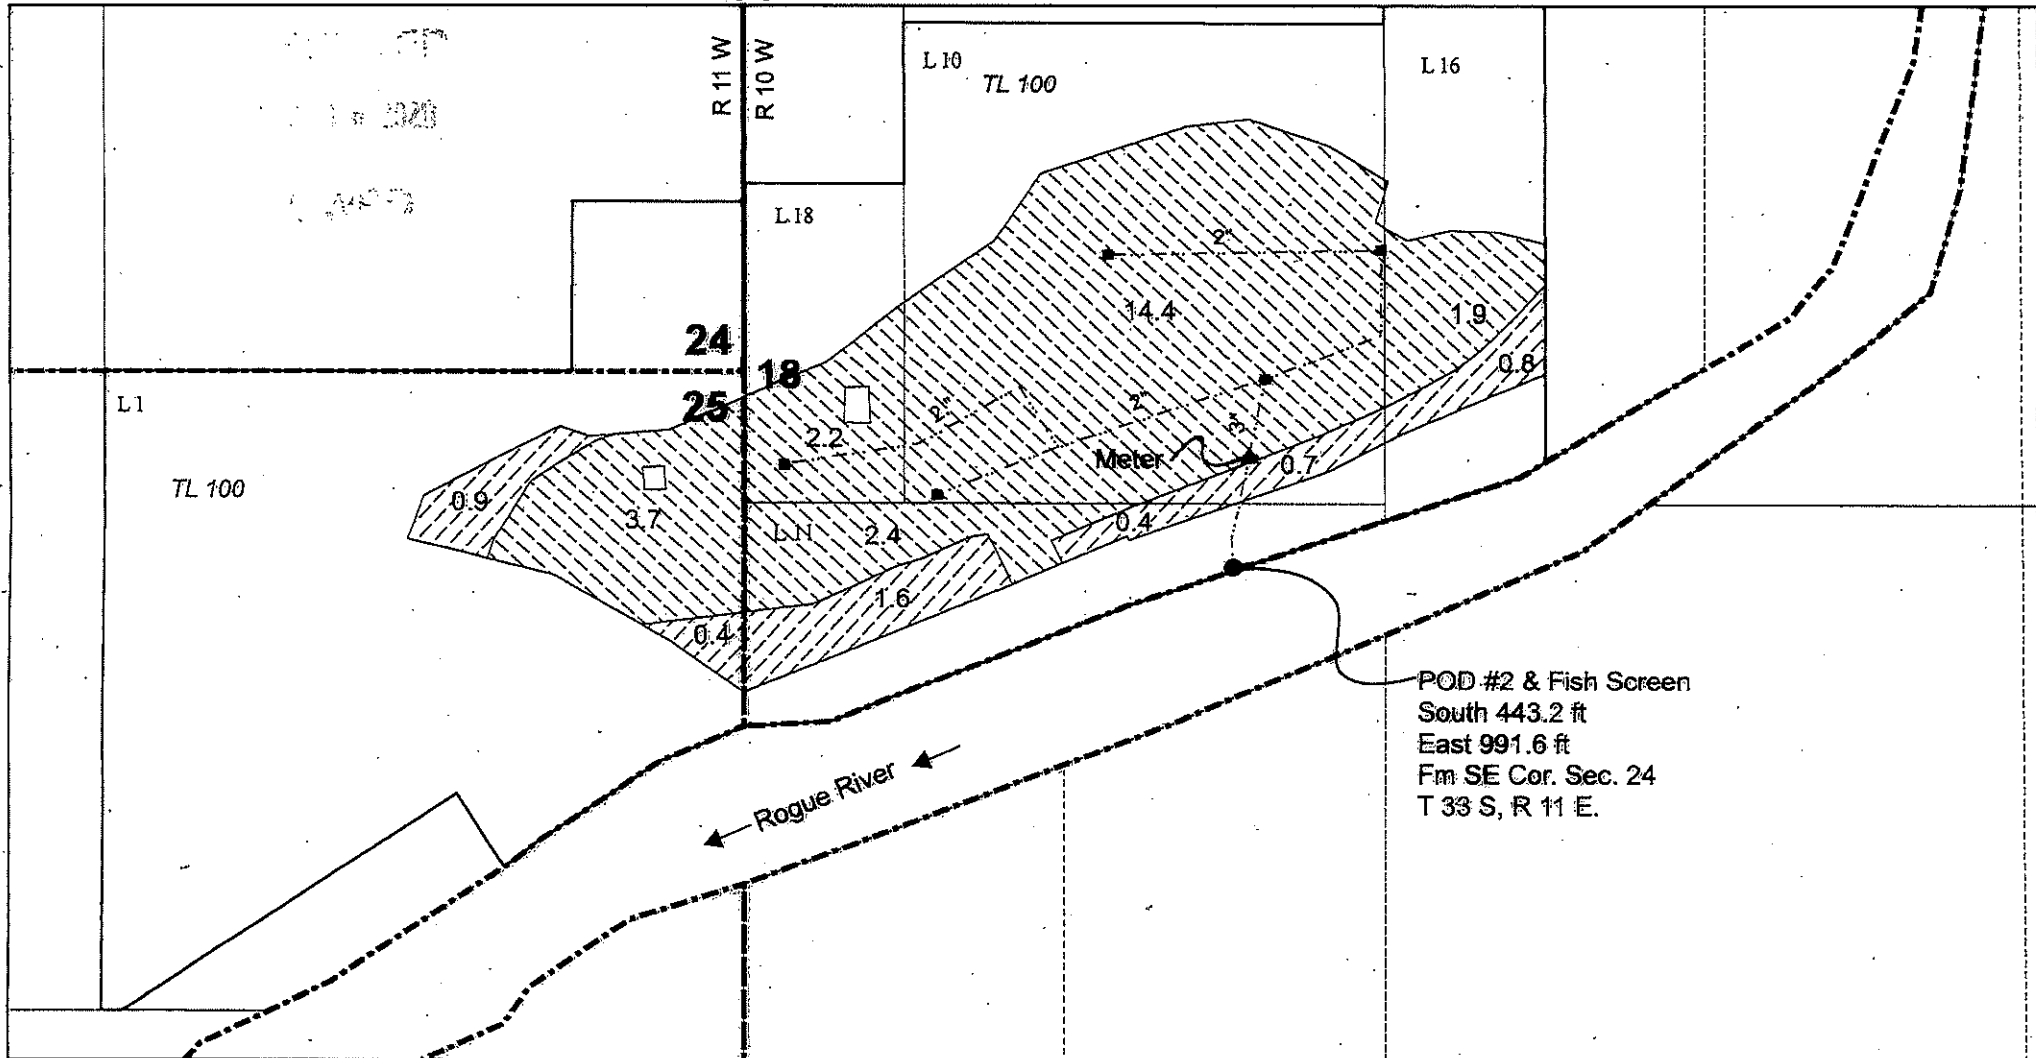

POD #2 & Fish Screen
 South 443.2 ft
 East 991.6 ft
 Fm SE Cor. Sec. 24
 T 33 S, R 11 E.

Legend

-  Primary 4.8 Ac
-  Supplemental 24.6 ac
-  Pipelines
-  water meter
-  Outlet Valve

N



1 inch = 400 feet

**Note: This map is not intended
 to provide legal dimensions or
 locations of property ownership
 lines.**

