


CLAIM OF BENEFICIAL USE MAP

LOCATED IN SECTION 26, TAX LOT 900, TOWNSHIP 1 SOUTH,
RANGE 3 WEST, W.M., WASHINGTON COUNTY, OREGON.
FARM ADDRESS: 33840 SW UNGER ROAD, COORNELIUS OR 97113

APPLICATION S-88159	PERMIT S-54989
------------------------	-------------------

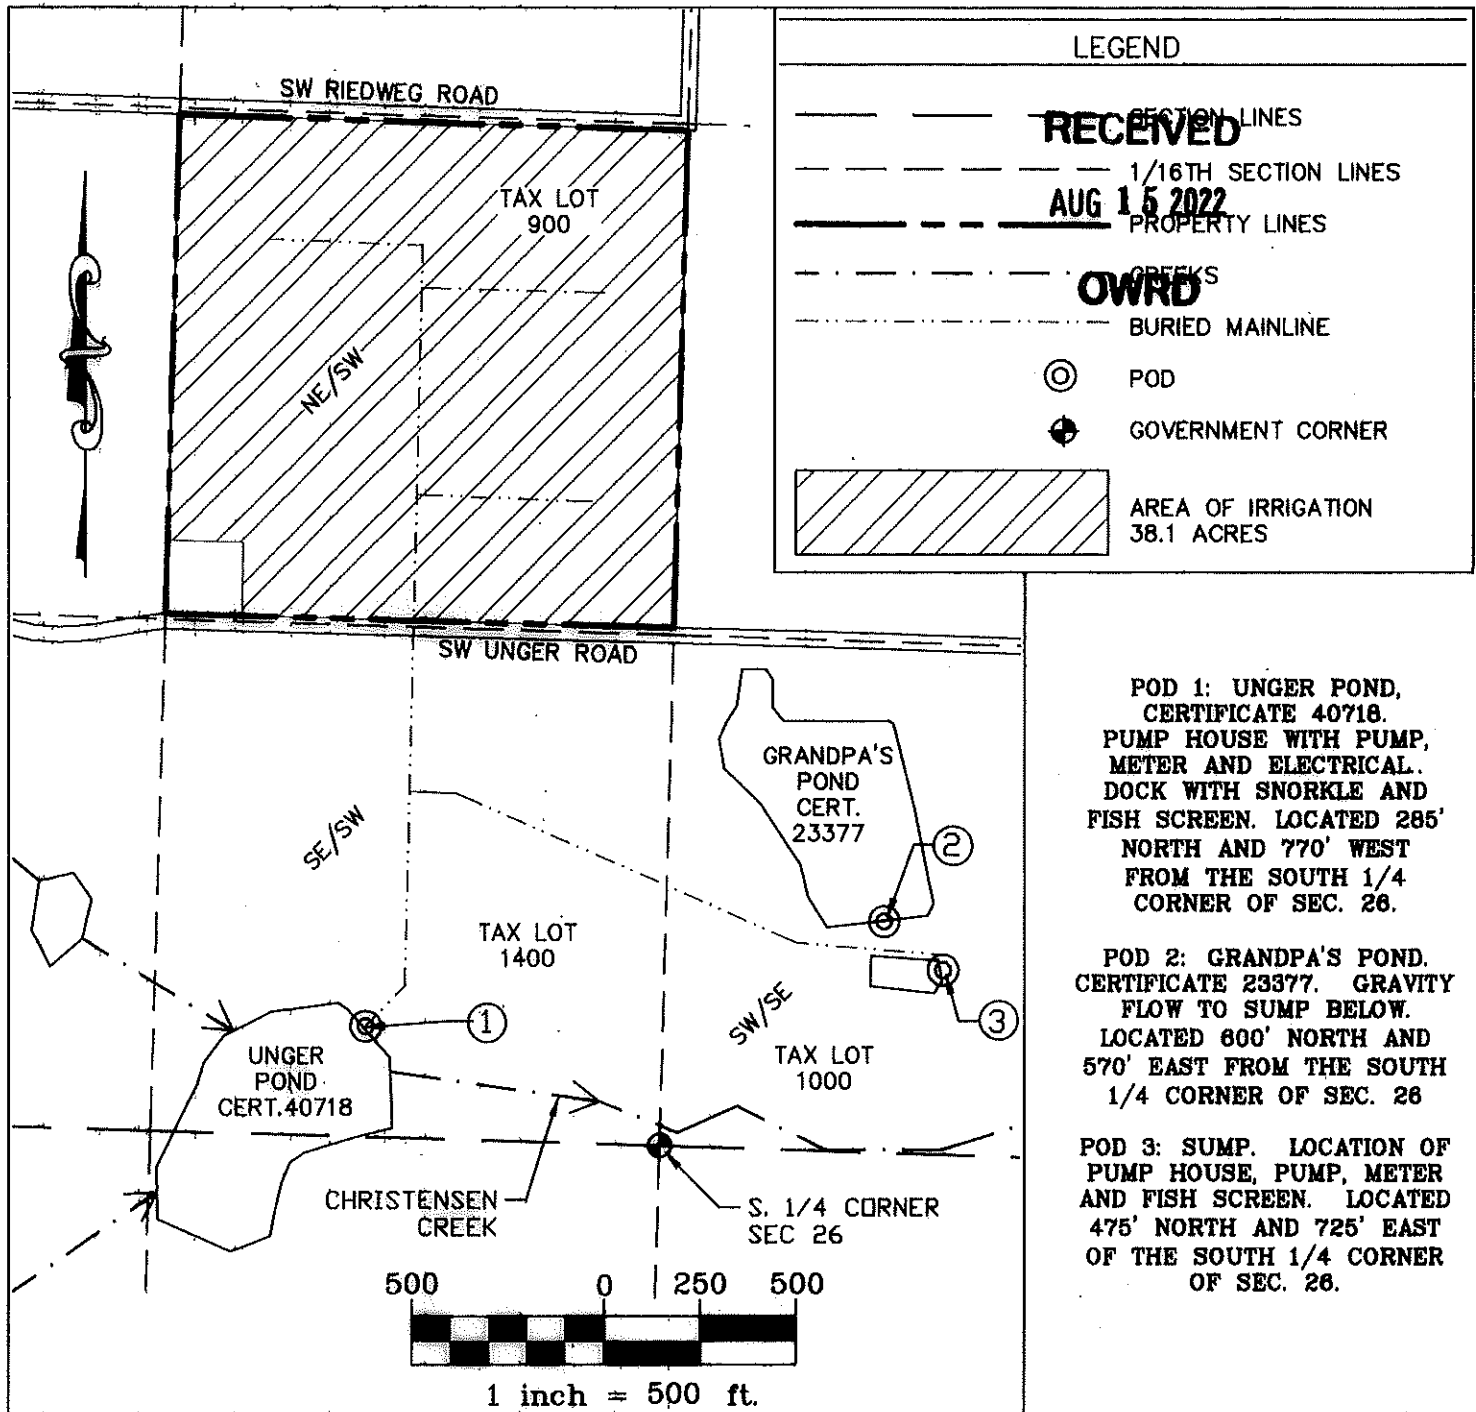

The preparation of this map was for the purpose of identifying the location of the Water Right only and has no intent to provide dimensions or location of property ownership lines.


IN THE NAME OF:
UNGER FAMILY FARMS INC.



ENGINEERING * LAND SURVEYING
FORESTRY * PLANNING * WATER RIGHTS

JOB# 315-059, REVISED 8-12-22
DRAWING : UNGER COBU MAP.DWG

2316-B PACIFIC AVENUE TEL: (503) 357-5717
FOREST GROVE, OR 97116 FAX: (503) 357-5698

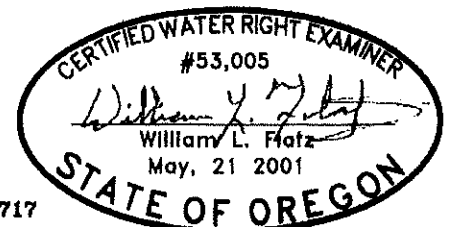

EXPIRES 12/31/2023