

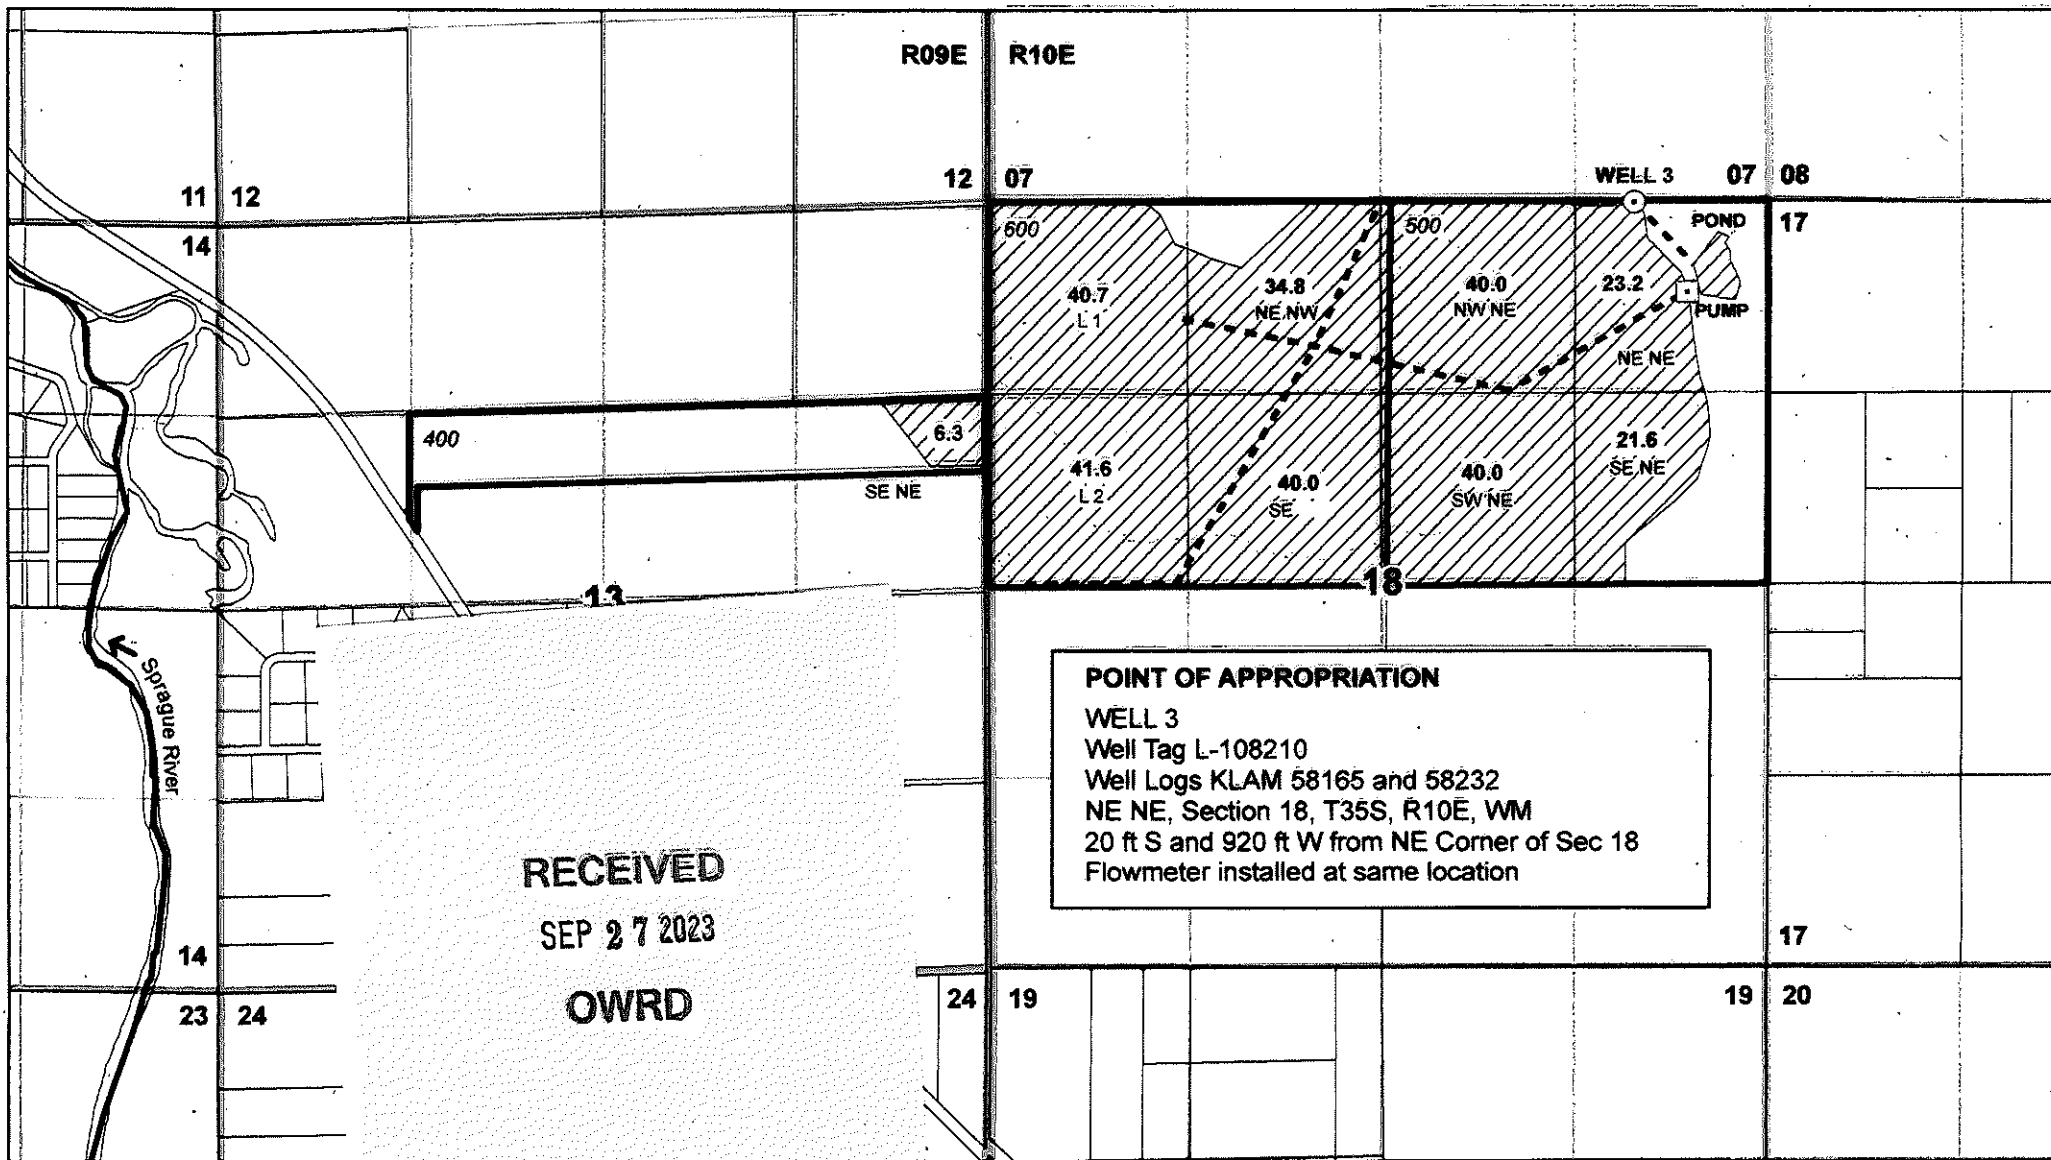


SECTION 13, T35S, R09E AND SECTION 18, T35S, R10E, WM -- KLAMATH COUNTY

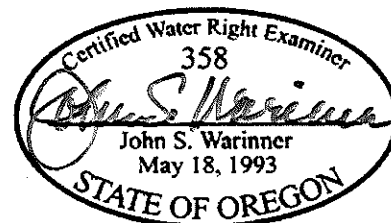

DISCLAIMER
 This map is not
 intended to provide
 legal dimensions or
 locations of property
 ownership lines.

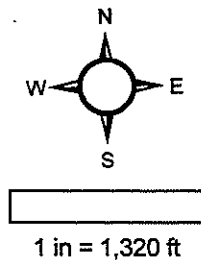

CLAIM OF BENEFICIAL USE MAP
Application G-12843
Permit G-13000
 in the name of
JOHN & MARLENE BLES
 Revised 2023-08-29