


T15S, R27E, W.M.
Grant County, Oregon

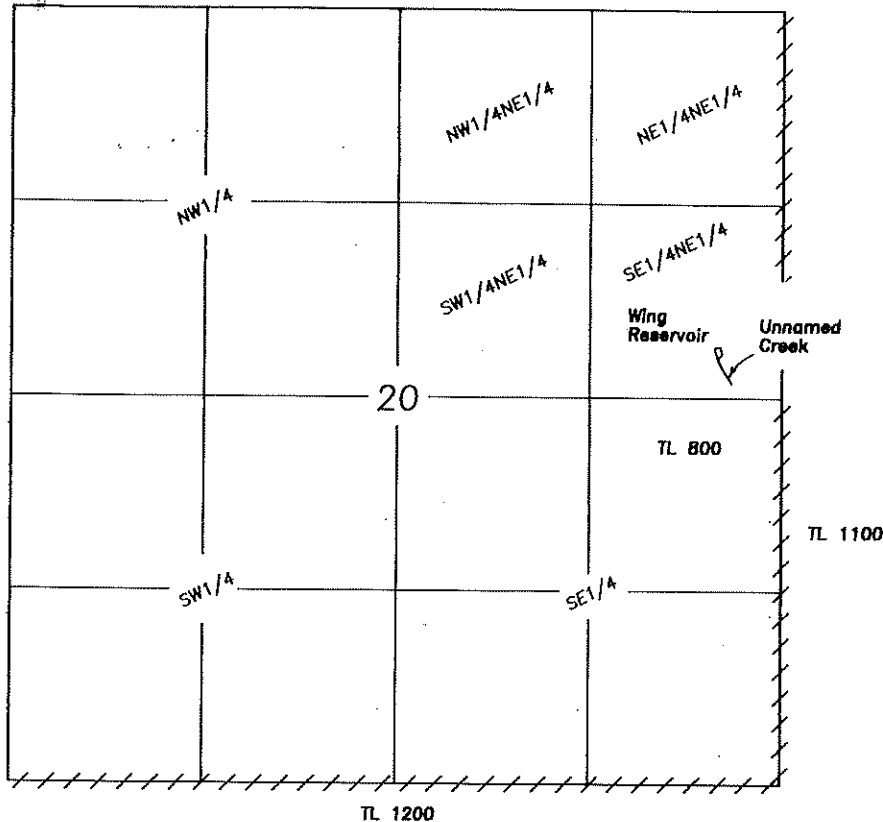

Outlet is located 2290' South & 420' West of the
NE corner of Section 20.

RECEIVED

MAY 08 2022

OWRD



SCALE 1"=1320'

LEGEND

Application No. R-59567
Permit No. R-8004
Priority 12/21/1979

//// Tax Lot Boundary

A portion of Tax Lot
15-27 TL800

NOTE: Tax Lot 800 is owned by the BLM
and is more that 5700 acres.
A portion of the tax lot boundary
is shown.

NOTE: The preparation of this map
was for the purpose of identifying
the location of the proposed water
right and has no intent to provide
dimensions or location of property
ownership lines.

FINAL PROOF SURVEY CLAIM OF BENEFICIAL USE WING RESERVOIR

For

Bureau of Land Managment

June 30, 2020

Prepared by

Cornerstone Surveying, Inc

P.O. BOX 33

JOHN DAY, OR. 97845

(541)575-1813

jwsurvey55@gmail.com

