


RECEIVED

MAY 02 2022

OWRD

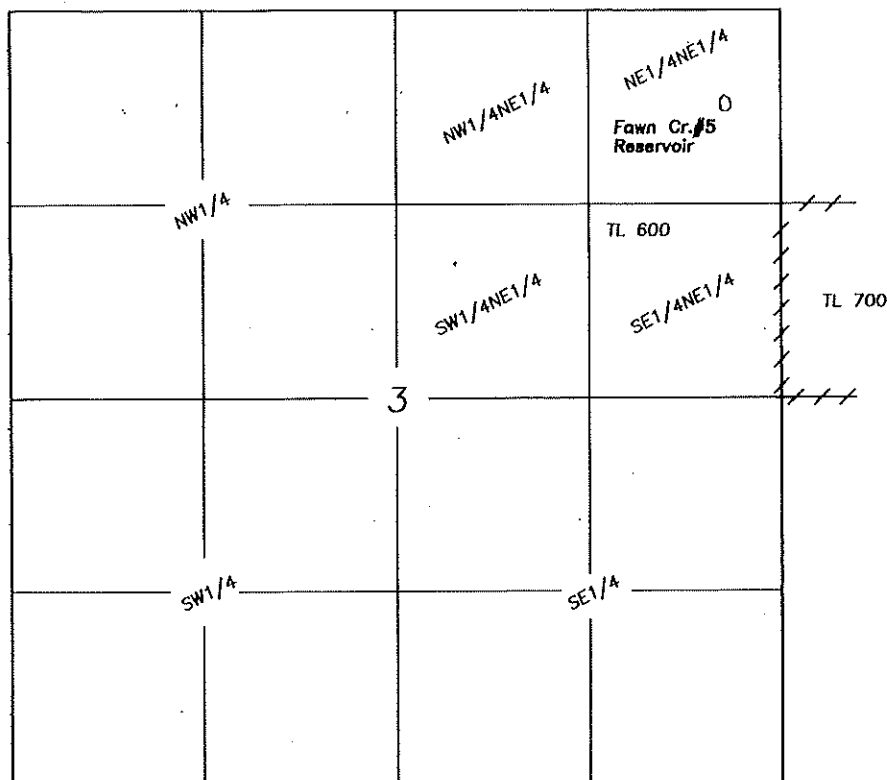

SCALE 1"=1320'

There is no outlet, the dam is located 630' South & 350' West of the NE corner of Section 3.

FINAL PROOF SURVEY
CLAIM OF BENEFICIAL USE
FAWN CREEK #5 RESERVOIR

For

Bureau of Land Managment

July 16, 2020

LEGEND

Application No. R-59571

Permit No. R-8005

Priority 12/21/1979

//// Tax Lot Boundary

A portion of Tax Lot
15-27 TL800

NOTE: Tax Lot 600 is owned by the BLM
and is more that 5200 acres.
A portion of the tax lot boundary
is shown.

NOTE: The preparation of this map was for the purpose of identifying the location of the proposed water right and has no intent to provide dimensions or location of property ownership lines.

Prepared by
Cornerstone Surveying, Inc

P.O. BOX 33

JOHN DAY, OR. 97845

(541)575-1813

jwsurvey55@gmail.com

