


T15S, R27E, W.M.  
Grant County, Oregon

RECEIVED

MAY 02 2022

OWRD

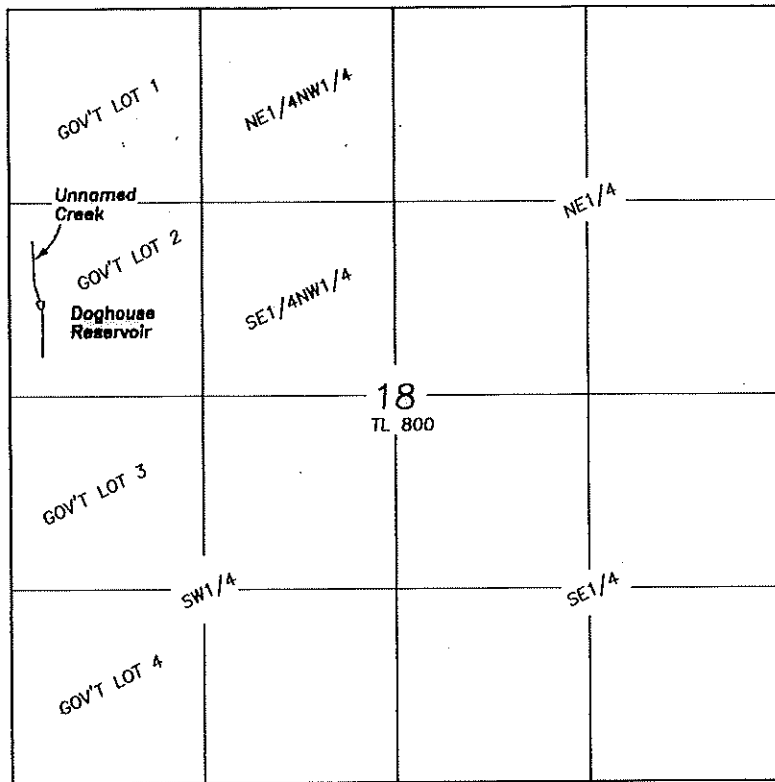

SCALE 1"=1320'

Outlet is located 2010' South & 190' East of the  
NW corner of Section 18.

FINAL PROOF SURVEY  
CLAIM OF BENEFICIAL USE  
DOGHOUSE RESERVOIR

For

Bureau of Land Management  
July 14, 2020

LEGEND

Application No. R-59573  
Permit No. R-8006  
Priority 12/21/1979

Tax Lot  
15-27 TL800

NOTE: Tax Lot 800 is owned by the BLM  
and is more that 5,700 acres.

NOTE: The preparation of this map  
was for the purpose of identifying  
the location of the proposed water  
right and has no intent to provide  
dimensions or location of property  
ownership lines.

Prepared by  
Cornerstone Surveying, Inc  
P.O. BOX 33  
JOHN DAY, OR. 97845  
(541)575-1813  
jwsurvey55@gmail.com

