


T13S, R26E, W.M.
Grant County, Oregon

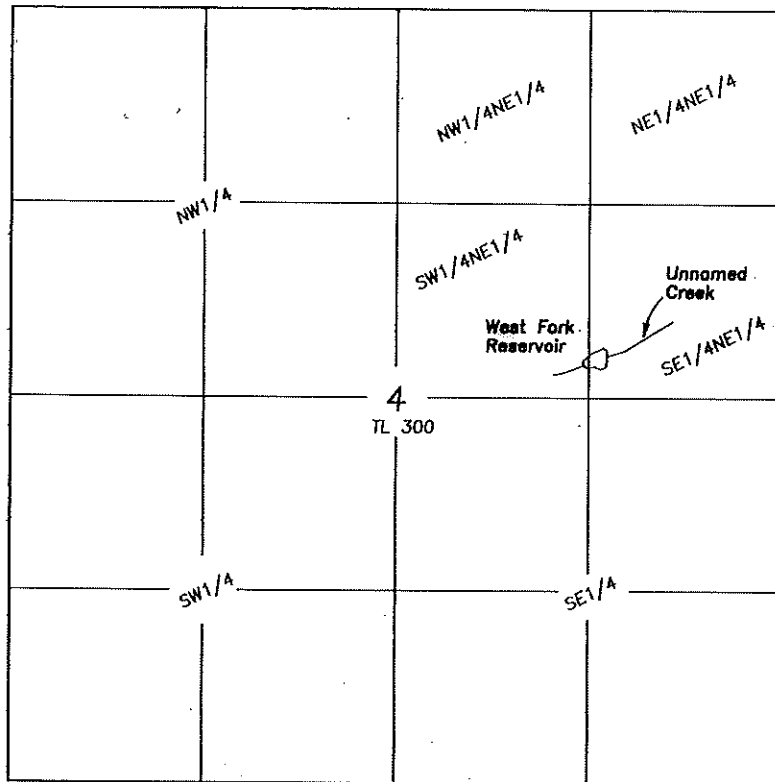

Outlet is located 2430' South & 1200' West of the
NE corner of Section 4.



SCALE 1"=1320'

RECEIVED

MAY 02 2022

OWRD

LEGEND

Application No. R-59574
Permit No. R-8007
Priority 12/21/1979

Tax Lot
13-26 TL300

NOTE: Tax Lot 300 is owned by the BLM
and is more that 12,400 acres.

NOTE: The preparation of this map
was for the purpose of identifying
the location of the proposed water
right and has no intent to provide
dimensions or location of property
ownership lines.

FINAL PROOF SURVEY
CLAIM OF BENEFICIAL USE
WEST FORK RESERVOIR

For

Bureau of Land Managment

July 15, 2020

Prepared by

Cornerstone Surveying, Inc

P.O. BOX 33

JOHN DAY, OR. 97845

(541)575-1813

jwsurvey55@gmail.com

