


T16S, R27E, W.M.
Grant County, Oregon

RECEIVED

MAY 08 2022

OWRLD

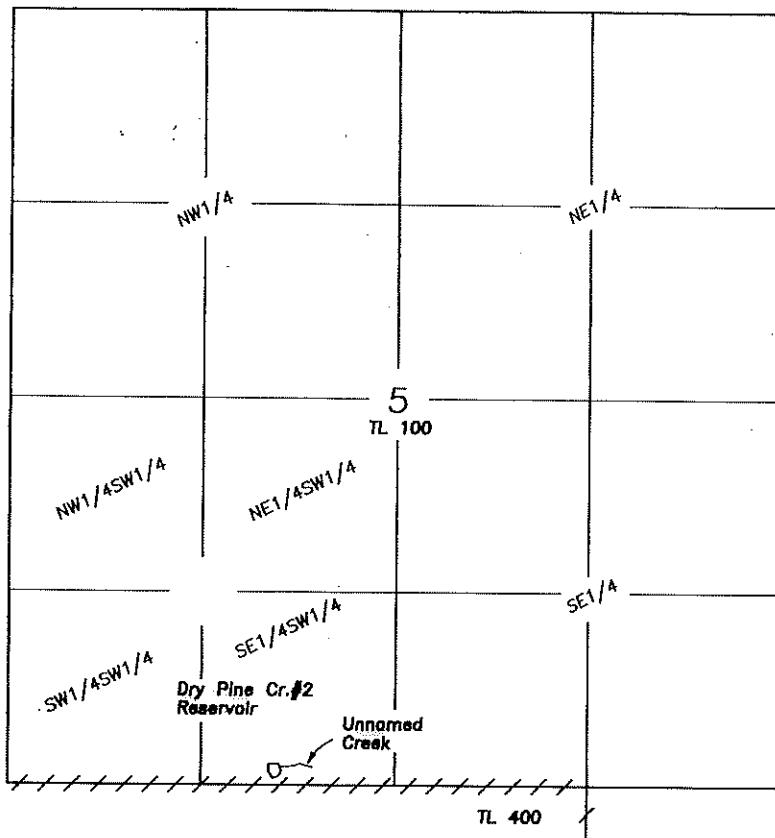

Outlet is located 50' North & 1810' East of the
SW corner of Section 5.

SCALE 1"=1320'

FINAL PROOF SURVEY
CLAIM OF BENEFICIAL USE
DRY PINE CREEK #2 RESERVOIR

For

Bureau of Land Management

July 1, 2020

LEGEND

Application No. R-59577

Permit No. R-8010

Priority 12/21/1979

//// Tax Lot Boundary

A portion of Tax Lot
15-27 TL100

NOTE: Tax Lot 100 is owned by the BLM
and is more that 17,500 acres.
A portion of the tax lot boundary
is shown.

NOTE: The preparation of this map
was for the purpose of identifying
the location of the proposed water
right and has no intent to provide
dimensions or location of property
ownership lines.

Prepared by

Cornerstone Surveying, Inc

P.O. BOX 33

JOHN DAY, OR. 97845

(541)575-1813

jwsurvey55@gmail.com

