


T16S, R27E, W.M.
Grant County, Oregon

RECEIVED

MAY 02 2022

OWRD

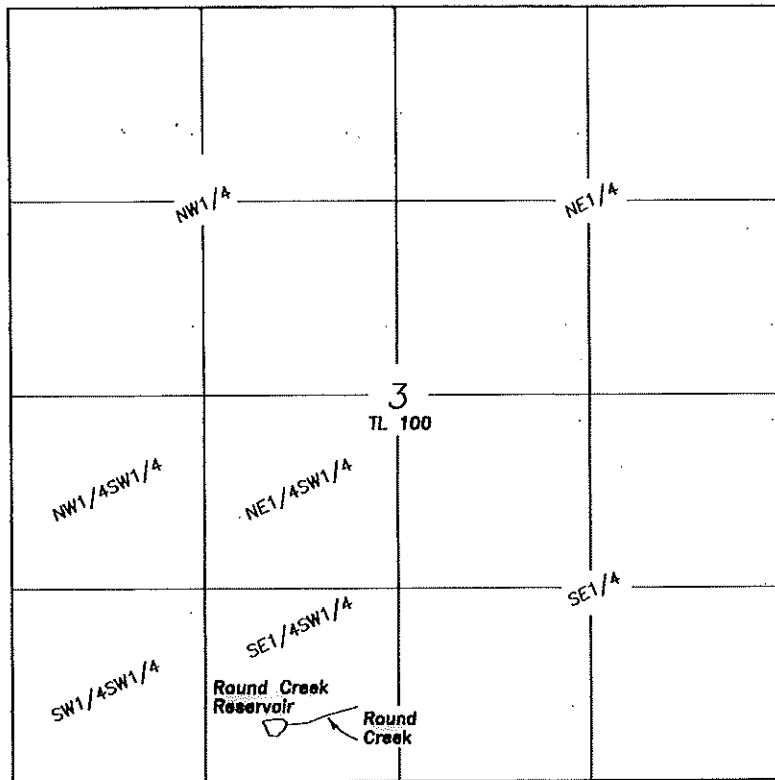

SCALE 1"=1320'

Outlet is located 330' North & 1740' East of the
SW corner of Section 3.

FINAL PROOF SURVEY
CLAIM OF BENEFICIAL USE
ROUND CREEK RESERVOIR

For

Bureau of Land Management

July 6, 2020

LEGEND

Application No. R-59578
Permit No. R-8011
Priority 12/21/1979

A portion of Tax Lot
16-27 TL100

NOTE: Tax Lot 100 is owned by the BLM
and is more that 17,500 acres.

NOTE: The preparation of this map
was for the purpose of identifying
the location of the proposed water
right and has no intent to provide
dimensions or location of property
ownership lines.

Prepared by
Cornerstone Surveying, Inc

P.O. BOX 33
JOHN DAY, OR. 97845
(541)575-1813
jwsurvey55@gmail.com

