


T18S, R24E, W.M.
Crook County, Oregon

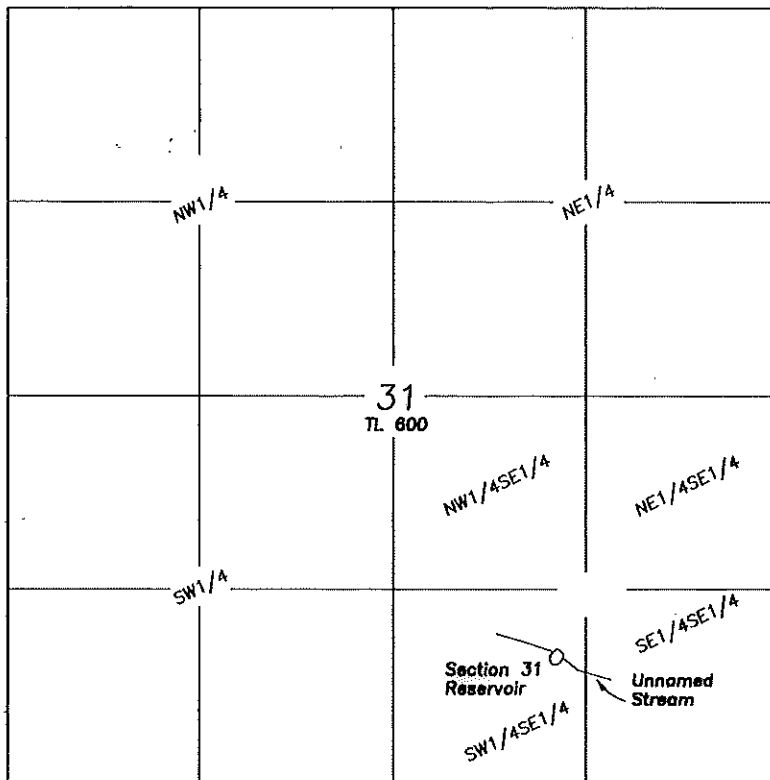

Outlet is located 900' North & 1500' West of the
SE corner of Section 31.

RECEIVED

MAY 02 2022

OWRD



SCALE 1"=1320'

FINAL PROOF SURVEY
CLAIM OF BENEFICIAL USE
SECTION 31 RESERVOIR

For

Bureau of Land Management

July 22, 2020

LEGEND

Application No. R-66059
Permit No. R-11891
Priority 1/4/1985

A portion of Tax Lot
18-24 TL600

NOTE: Tax Lot 600 is owned by the BLM
and is more that 5,800 acres.

NOTE: The preparation of this map
was for the purpose of identifying
the location of the proposed water
right and has no intent to provide
dimensions or location of property
ownership lines.

Prepared by

Cornerstone Surveying, Inc

P.O. BOX 33

JOHN DAY, OR. 97845

(541)575-1813

jwsurvey55@gmail.com

