


T16S, R22E, W.M.
Crook County, Oregon

RECEIVED

MAY 02 2022

OWRd

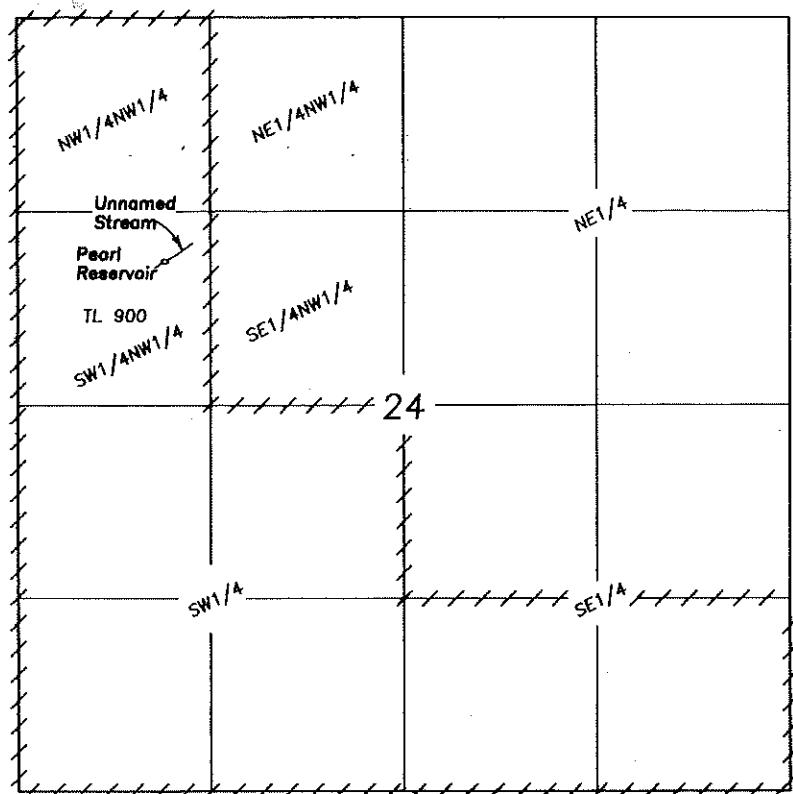

SCALE 1"=1320'

Outlet is located 1640' South & 990' East of the NW corner of Section 24.

LEGEND

Application No. R-66060
Permit No. R-11803
Priority 1/4/1985

----- Tax Lot Boundary

Tax Lot
16-22 TI 900

NOTE: Tax Lot 900 is owned by the BLM

FINAL PROOF SURVEY
CLAIM OF BENEFICIAL USE
PEARL RESERVOIR

For

Bureau of Land Management
July 9, 2020

Prepared by
Cornerstone Surveying, Inc
P.O. BOX 33
JOHN DAY, OR. 97845
(541)575-1813
jwsurvey55@gmail.com

NOTE: The preparation of this map was for the purpose of identifying the location of the proposed water right and has no intent to provide dimensions or location of property ownership lines.

