

Claim of Beneficial Use


Application R-84427, Permit R-13115

Cauthorn Springs, Julie Walker

RECEIVED

AUG 31 2011

OWNED

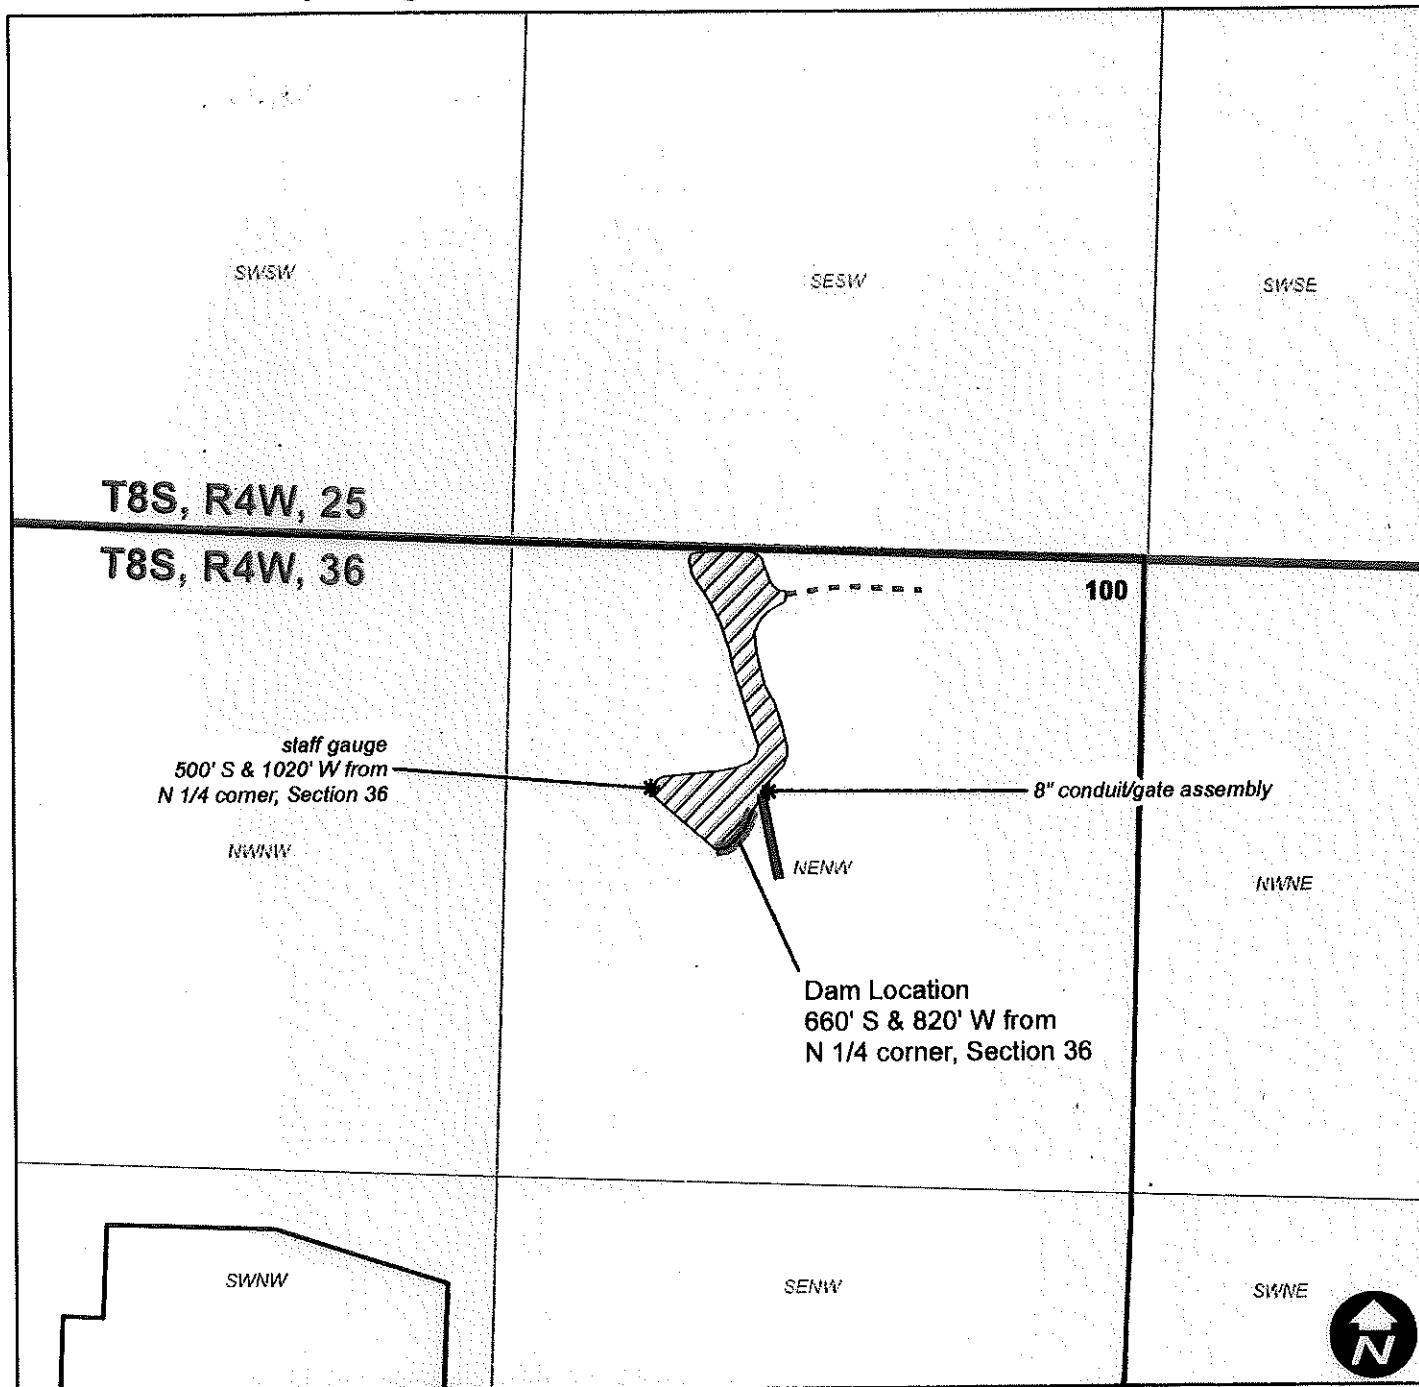

0 200 400 800 Feet

This map is not intended to provide legal dimensions or locations of property ownership lines.

Legend

- Reservoir
- Unnamed Stream
- Dam
- Taxlot
- Spillway



EXPIRES: 12/31/2022