


T14S R14E, WM
CROOK COUNTY, OREGON

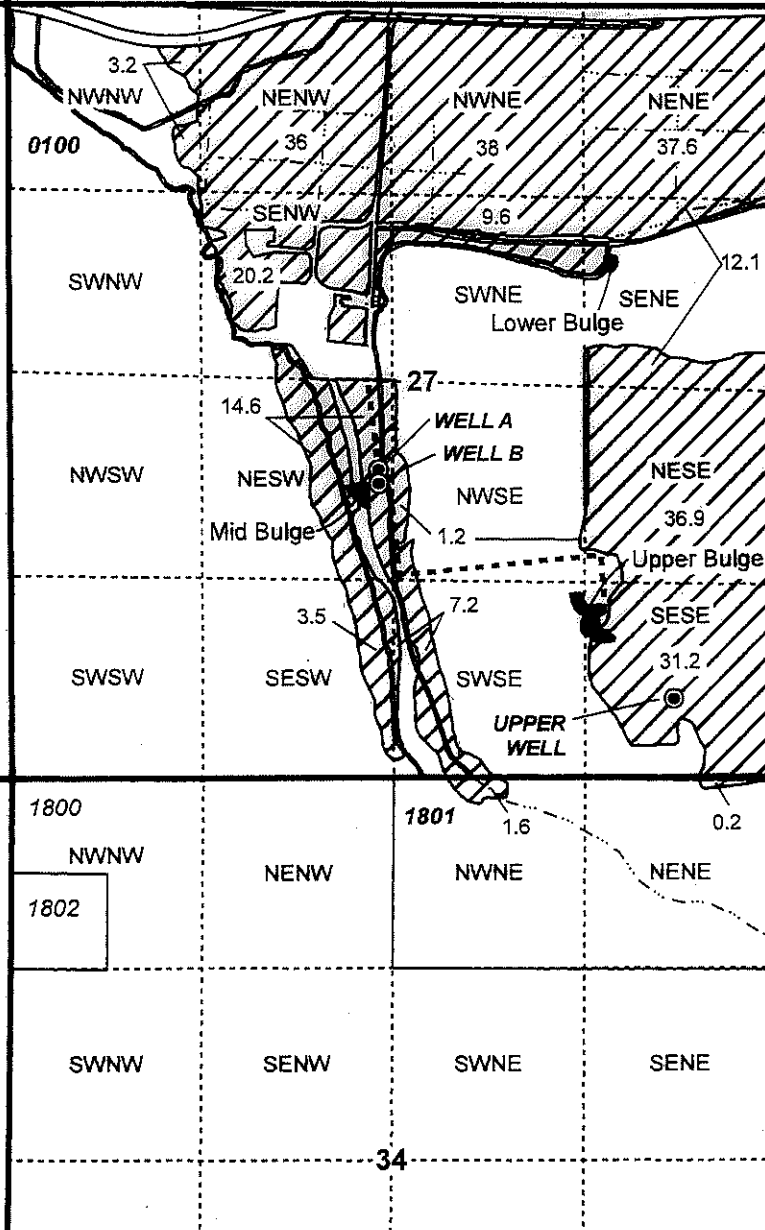


WELL LOCATIONS:

WELL A (CROO 3007/3024): 600' S, 100' W OF C 1/4 COR SEC 27
WELL B (CROO 3030/3056): 700' S, 100' W OF C 1/4 COR SEC 27
UPPER WELL (CROO 53552/L-91712): 540' N, 700' W OF SE COR SEC 27

RECEIVED

NOV 04 2021

OWRD

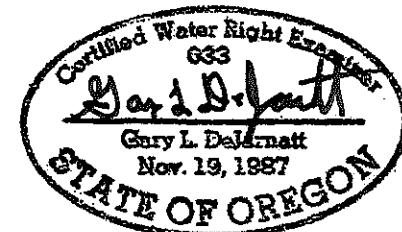

RENEWAL DATE 12/31/2021

CLAIM OF BENEFICIAL USE MAP
Radabaugh

NOTE: THIS MAP IS NOT INTENDED TO
PROVIDE LEGAL DIMENSIONS OR LOCATIONS
OF PROPERTY OWNERSHIP LINES.

WATER RIGHT SERVICES, LLC

PO BOX 1830, BEND, OR 97709

CCB# 197121 www.oregonwater.us

541-389-2837 JOHNSHORT@USA.COM

AP G-12442/T-12637

PERMIT G-18185

PROJECT #20079

Date: 12/31/2020