


**LEGEND**

	TOWNSHIP LINE
	SECTION LINE
	1/4 1/4 LINE
	STREAM
	TAX LOT LINE
	BURIED PIPE
	ROAD
$\frac{22}{22} \mid \frac{22}{22}$	SECTION CORNER
TL 0000	TAX LOT NUMBER
	POA (WELL)
	WATER USED UNDER PERMIT G-13324
	1/4 1/4 SECTION WHERE WATER WAS USED
	STORAGE TANK

- NOTES:**
1. THIS MAP WAS PREPARED FROM FIELD MEASUREMENTS, NAIP 2021 AERIAL PHOTOGRAPHY, JOSEPHINE COUNTY TAX MAP 34-6-36 AND OREGON GLO MAPS.
  2. THE PURPOSE OF THIS MAP IS TO IDENTIFY THE LOCATION OF THE WATER RIGHT ONLY, AND IS NOT INTENDED TO PROVIDE DIMENSIONS OR LOCATION OF PROPERTY LINES.
  3. DATE OF PRIORITY FOR THIS PERMIT IS OCTOBER 29, 1996.

**WELL LOCATION:**  
 WELL 1: 1980' NORTH & 680' EAST FROM THE SOUTHWEST CORNER OF SECTION 36.

RECEIVED  
 OCT 07 2021  
 DWRD

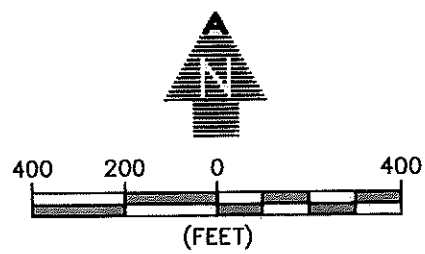

**CERTIFIED WATER RIGHT EXAMINER**  
 #88332GWRE  
*Daniel B. Scalas*  
 Daniel B. Scalas  
 April 23, 2015  
**STATE OF OREGON**  
 RENEWAL 08/30/22

**AL ADKINS** ENGINEERING & SURVEYING  
 o / 541.884.4666  
 w / AdkinsEngineering.com  
 1435 ESPLANADE AVENUE, KLAMATH FALLS, OR 97601  
 SERVING S. OREGON & N. CALIFORNIA

**CLAIM OF BENEFICIAL USE AND FINAL PROOF MAP**  
 FOR  
 GPRVR LLC  
 T34S, R6W, SEC. 36, WM  
 JOSEPHINE COUNTY, OREGON  
 PERMIT G-13324  
 APPLICATION G-14401