


26712 A-9 STOS # TAMUBOD COBUWAL 5022800

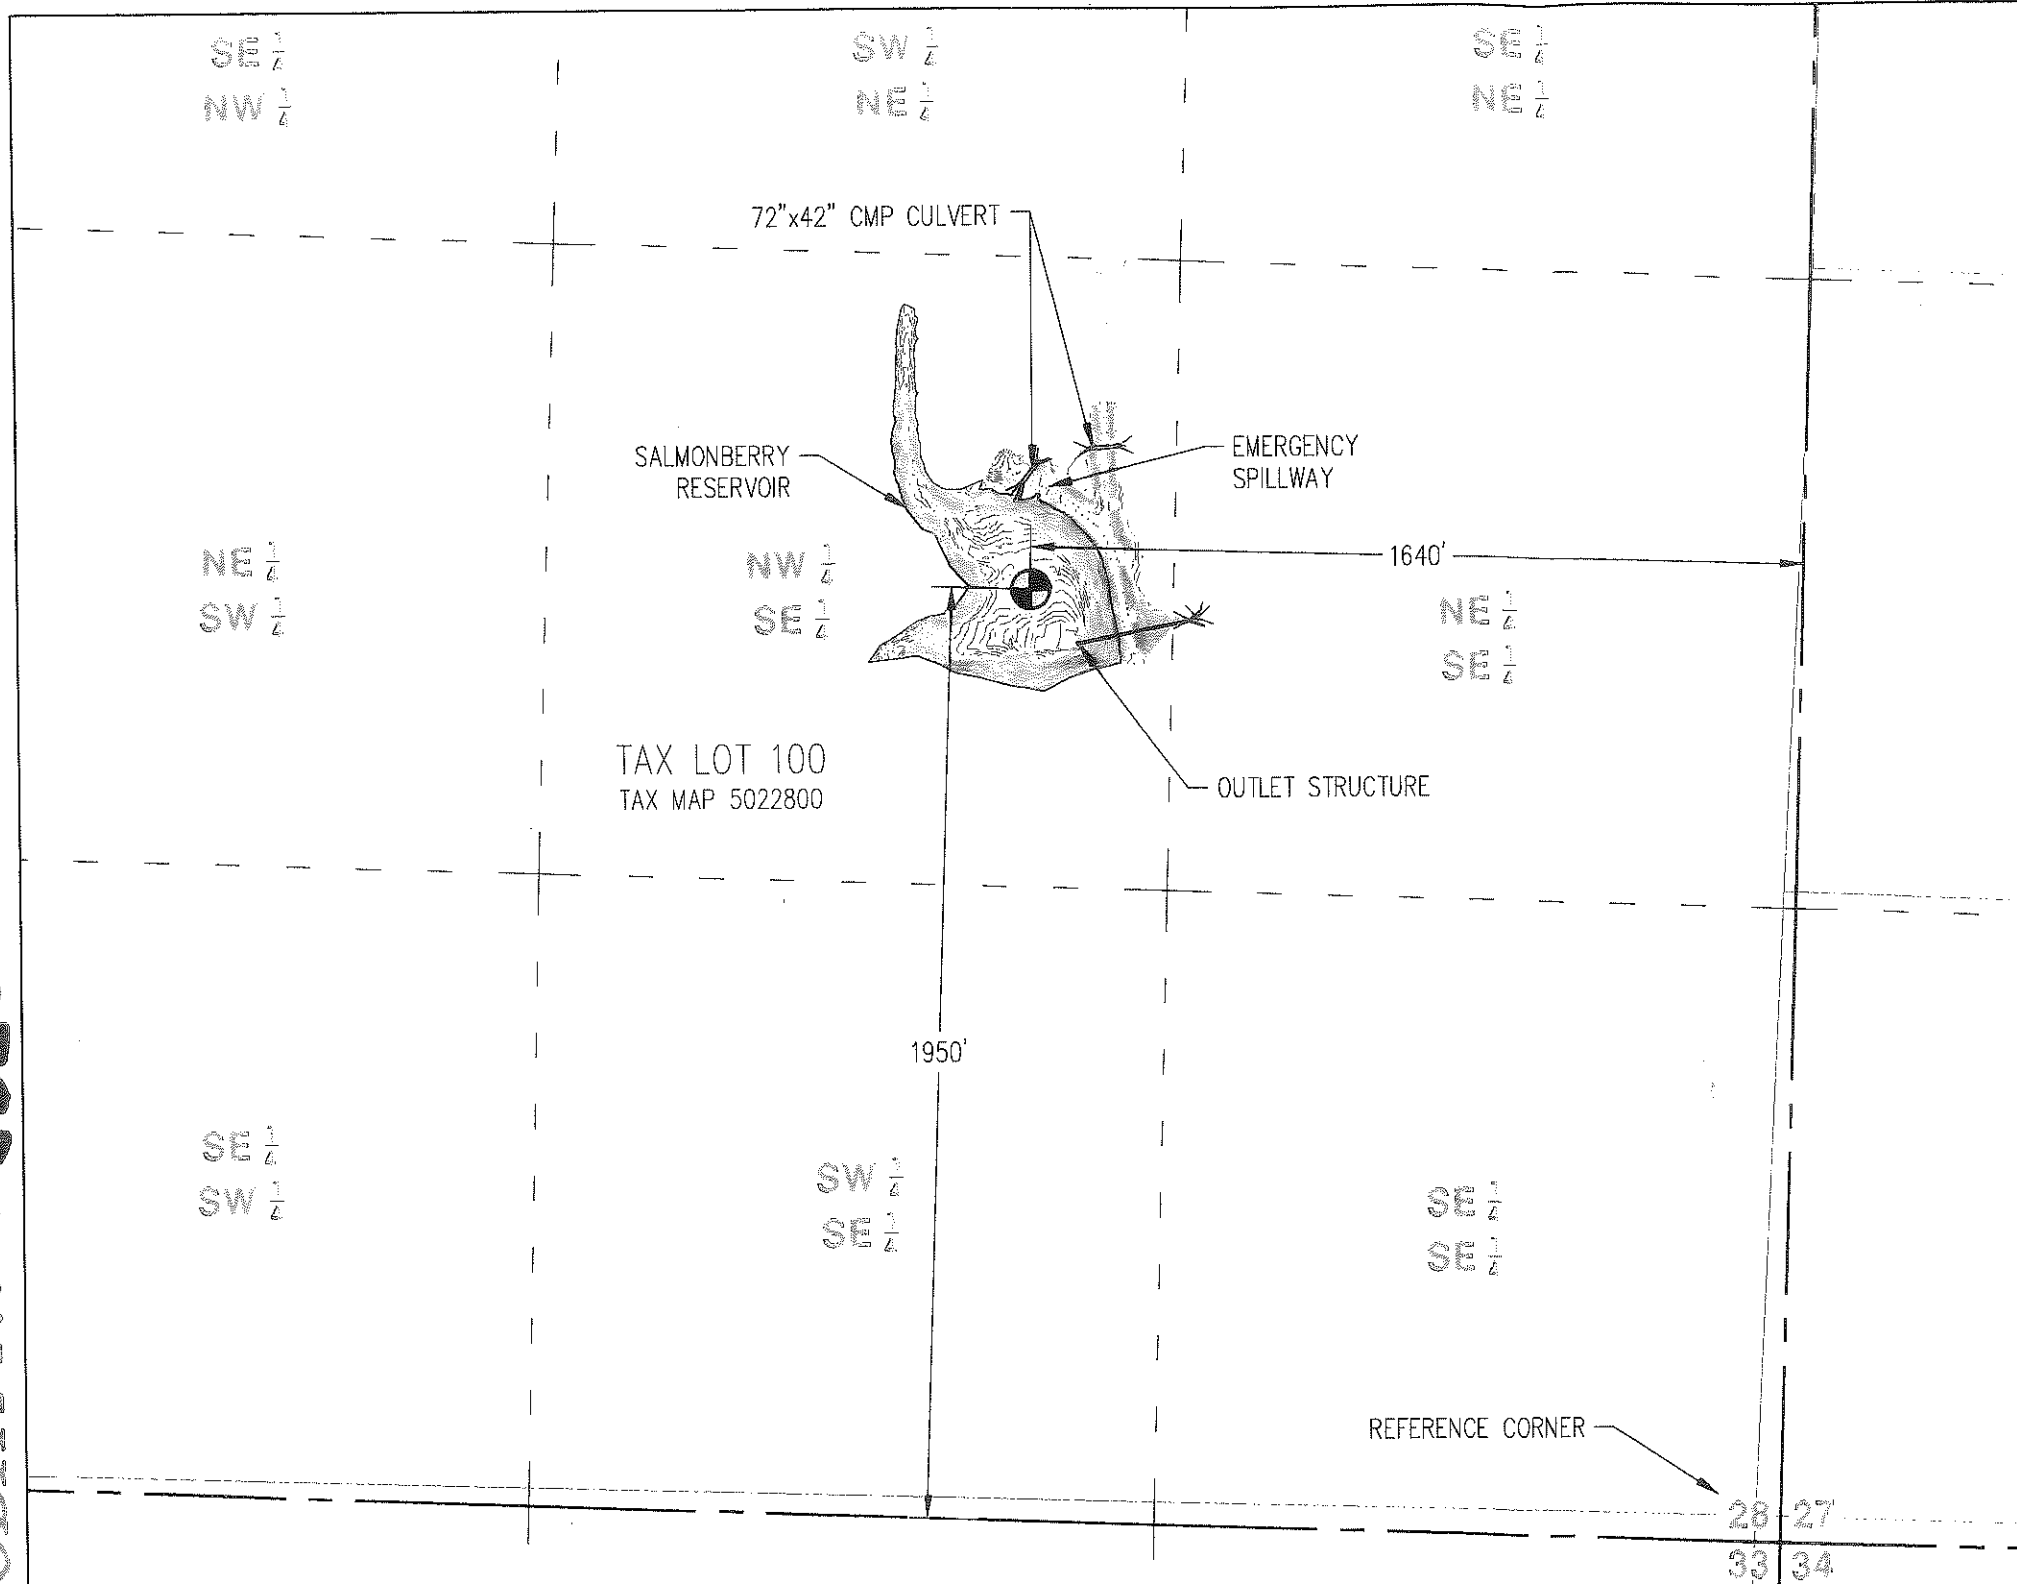

LOCATED IN
SECTION 28; T5N R2W W.M.
COLUMBIA COUNTY, OREGON
CLAIM OF BENEFICIAL USE MAP

TAX LOT 100
TAX MAP 5022800

APPLICATION R-63272
PERMIT R-11387

CWRE STATEMENT

THIS MAP IS NOT INTENDED TO PROVIDE LEGAL DIMENSIONS OF
LOCATIONS OF PROPERTY OWNERSHIP LINES.

MAP INFORMATION

COORDINATE SYSTEM: STATE PLANE OREGON NORTH ZONE 3601
DATUM: NORTH AMERICAN DATUM OF 1983

DATA SOURCES

TAX LOT AND ROAD: COLUMBIA COUNTY GIS
SECTION LINEWORK: COLUMBIA COUNTY GIS


PREPARED FOR

CITY OF ST. HELENS
265 STRAND STREET, OR 97051


RECEIVED

AUG 30 2023

OWRD

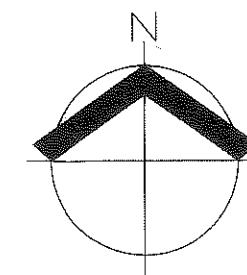

SCALE: 1" = 400 FEET

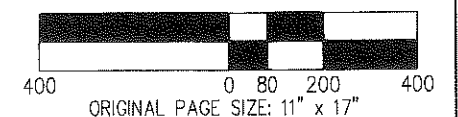

LEGEND

POINT OF APPROPRIATION (POA)




TAX LOT BOUNDARY

1/4 1/4 SECTION LINE

SECTION LINE

SALMONBERRY RESERVOIR
59.7 ACRE-FEET

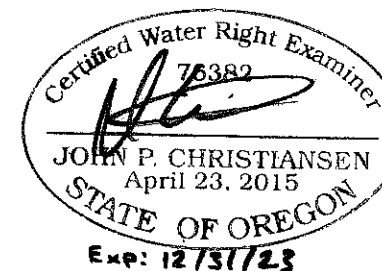

CLAIM OF BENEFICIAL USE MAP

SALMONBERRY RESERVOIR WATER RIGHTS

AKS ENGINEERING & FORESTRY, LLC
12965 SW HERMAN RD, STE 100
TUALATIN, OR 97062
503.563.6151 WWW.AKS-ENG.COM



EXHIBIT

A

DRWN: BGZ

CHKD: SRR

AKS JOB:

9935

DATE: 08/17/2023