


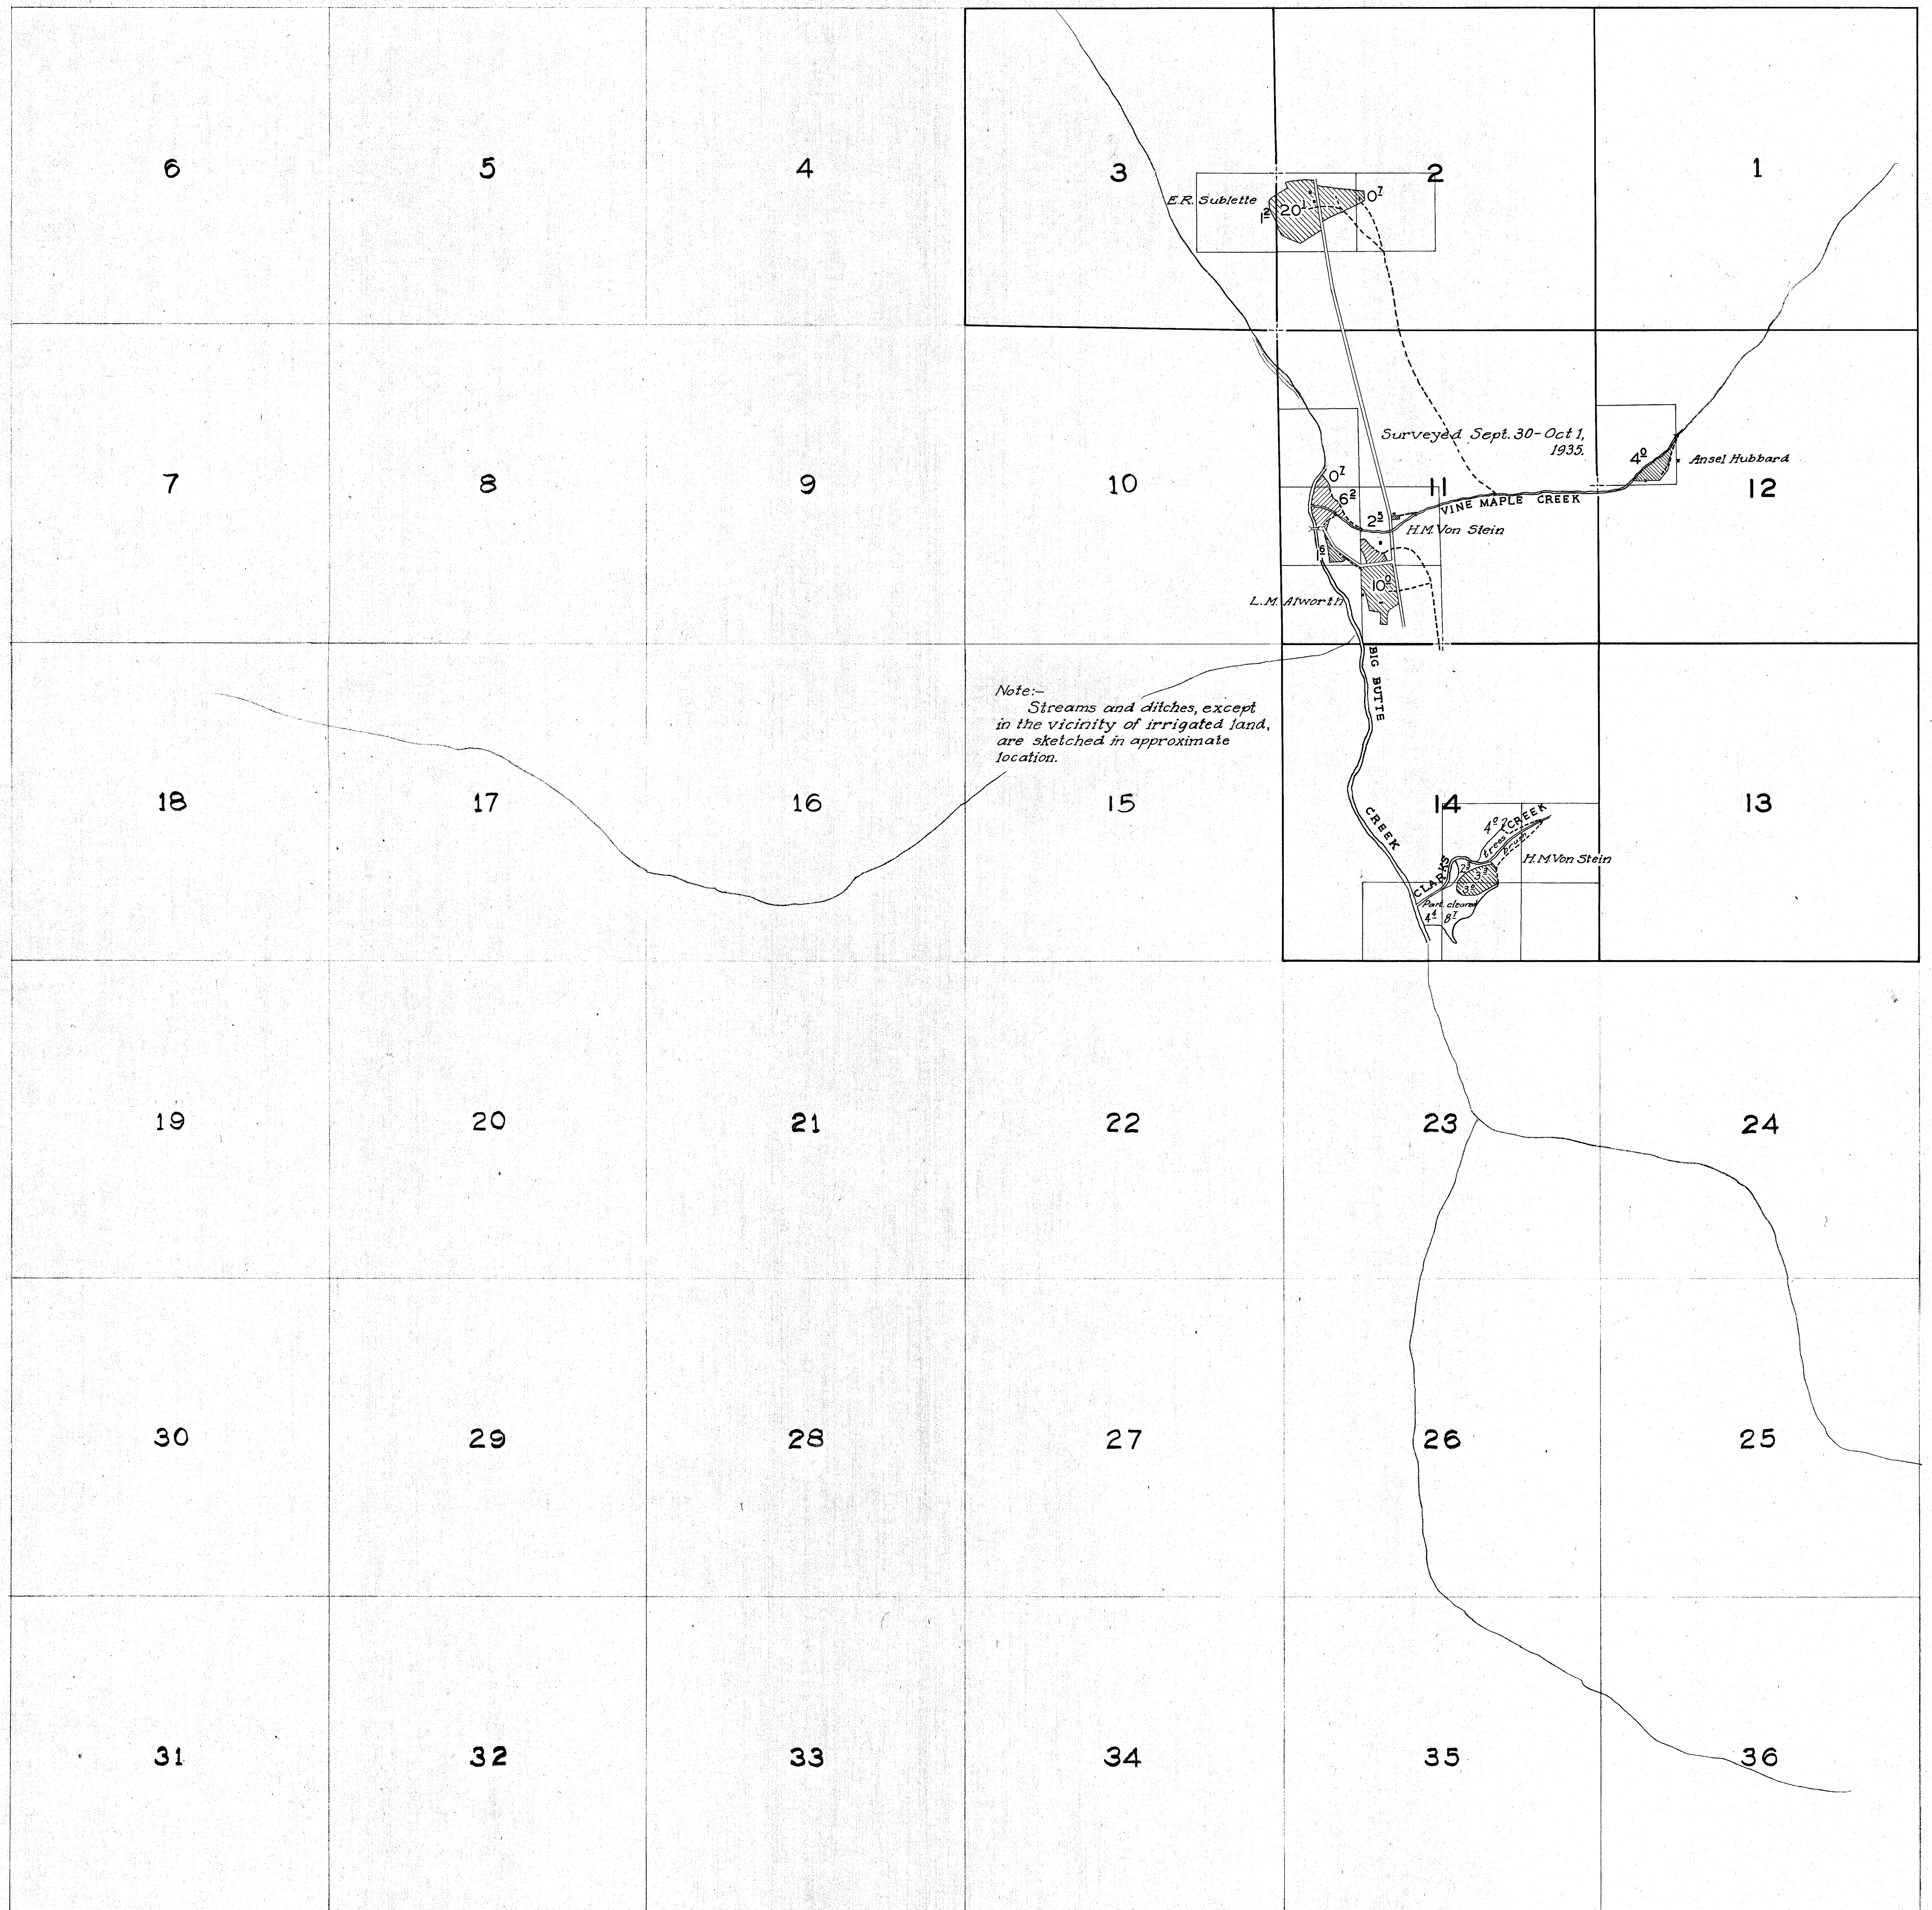


WATER RIGHT TRANSFER APPLICATION MAP

CERTIFICATE 47402 - PRIORITY DATE 1908
CHANGE IN CHARACTER OF USE AND PLACE OF USE

FOR
DAVID DAVERN
793 NETHERLANDS ROAD
TRAIL, OR 97541


SITUATED IN
SECTION 11, TOWNSHIP 34 SOUTH, RANGE 1 EAST, W.M.
JACKSON COUNTY, OREGON

0 200 400
SCALE: 1"=400'

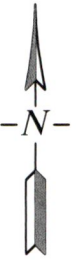

This map is not intended to
provide legal dimensions or
locations of property
ownership lines.

EHM-May 20, 2022

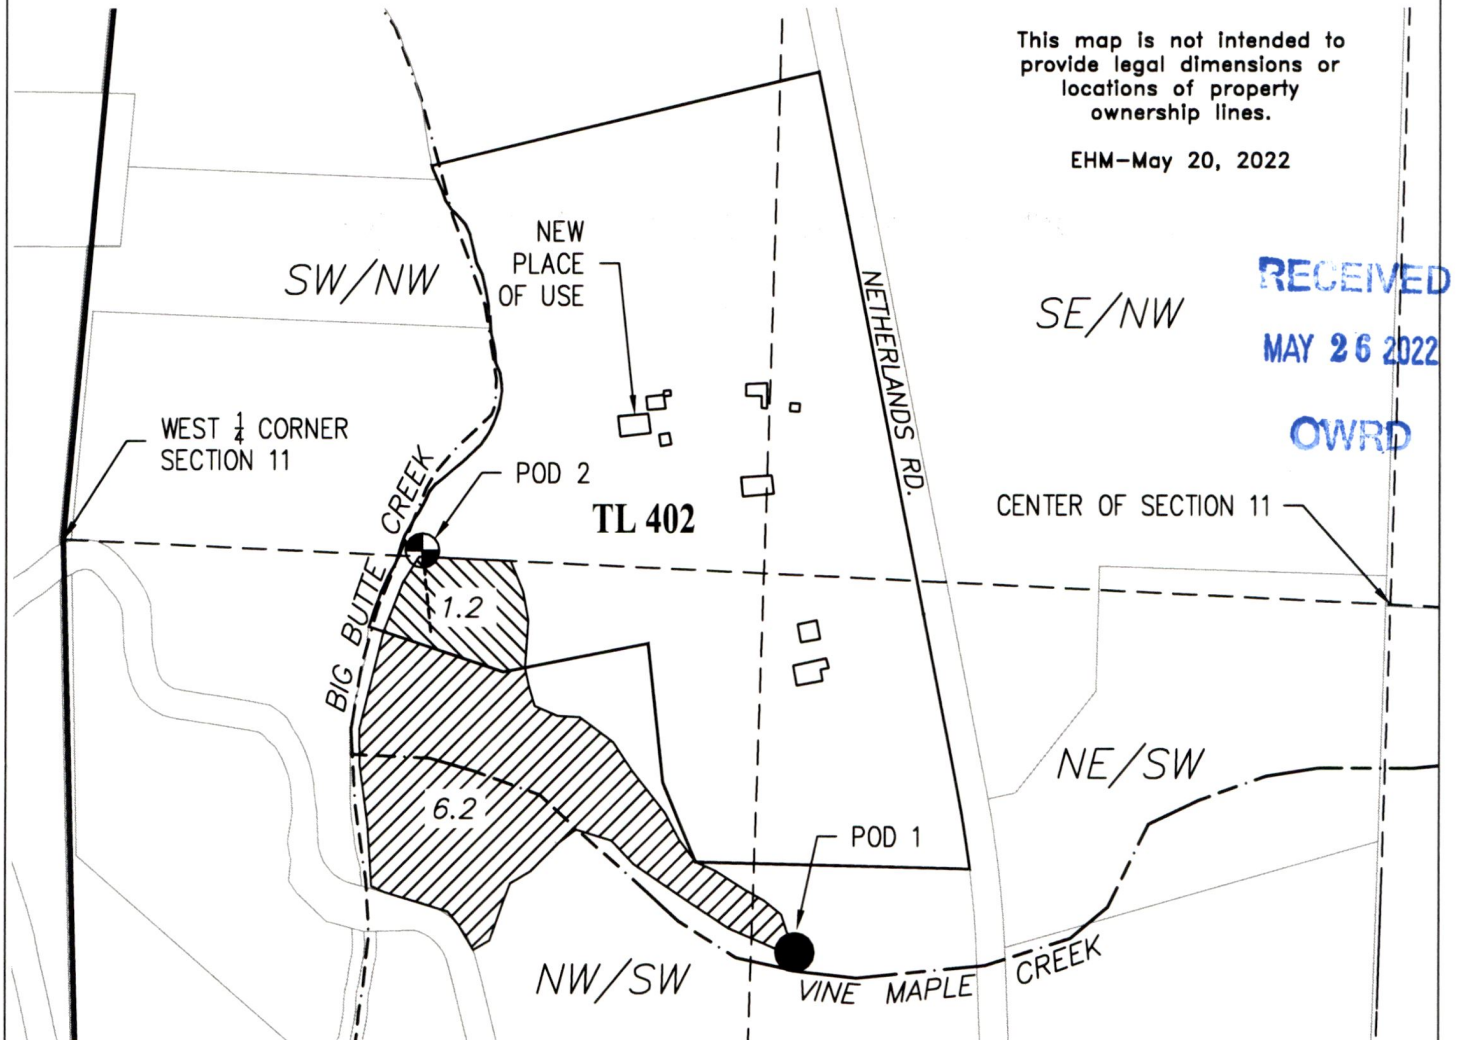

RECEIVED

MAY 26 2022

OWRD

LEGEND

- POD #1 (AUTHORIZED POINT OF DIVERSION)
726' SOUTH AND 1,244' WEST OF CENTER OF SECTION 11
- ⊕ POD #2 (ADDITIONAL POINT OF DIVERSION)
108' NORTH AND 2,028' WEST OF CENTER OF SECTION 11

- PLACE OF USE - NO CHANGES
- PLACE OF USE - CHANGE CHARACTER OF USE
FROM STOCK AND IRRIGATION TO DOMESTIC USE.
CHANGE PLACE OF USE TO RESIDENCE.
- 1/4-1/4 SECTION LINE
- - - - - EX. WATERLINE (APPROXIMATE)



RENEWS: 12/31/2022

ROGUE CIVIL LLC
emalepsy@roguecivil.com 541-621-2868

14019