
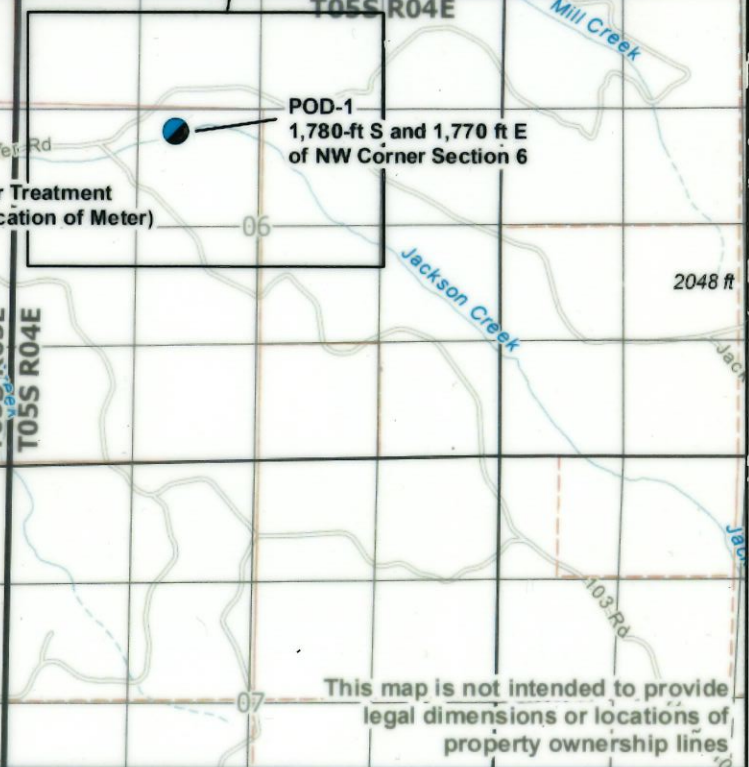
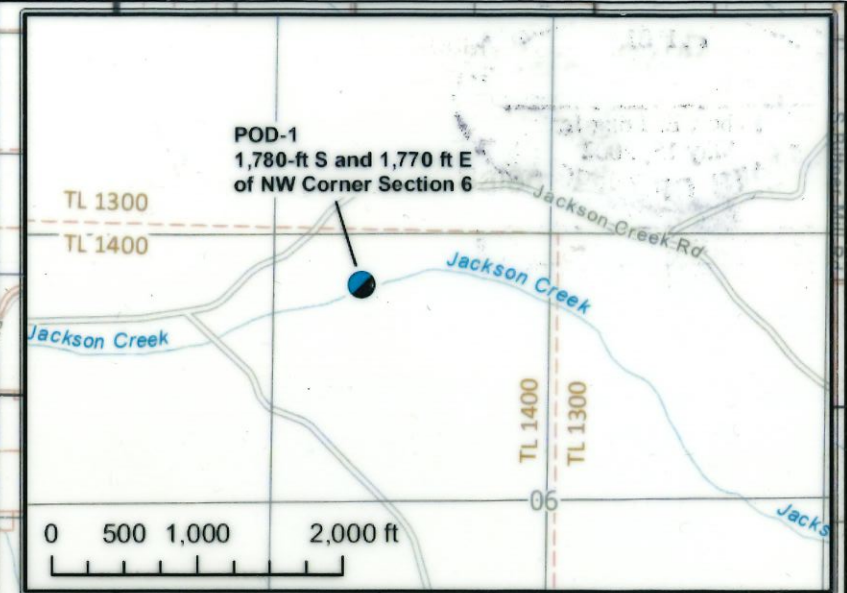


Certified Professional Engineer
 Robert E. Long Jr.
 May 15, 2002
 STATE OF OREGON
 EXPIRATION DATE 6.1.2024

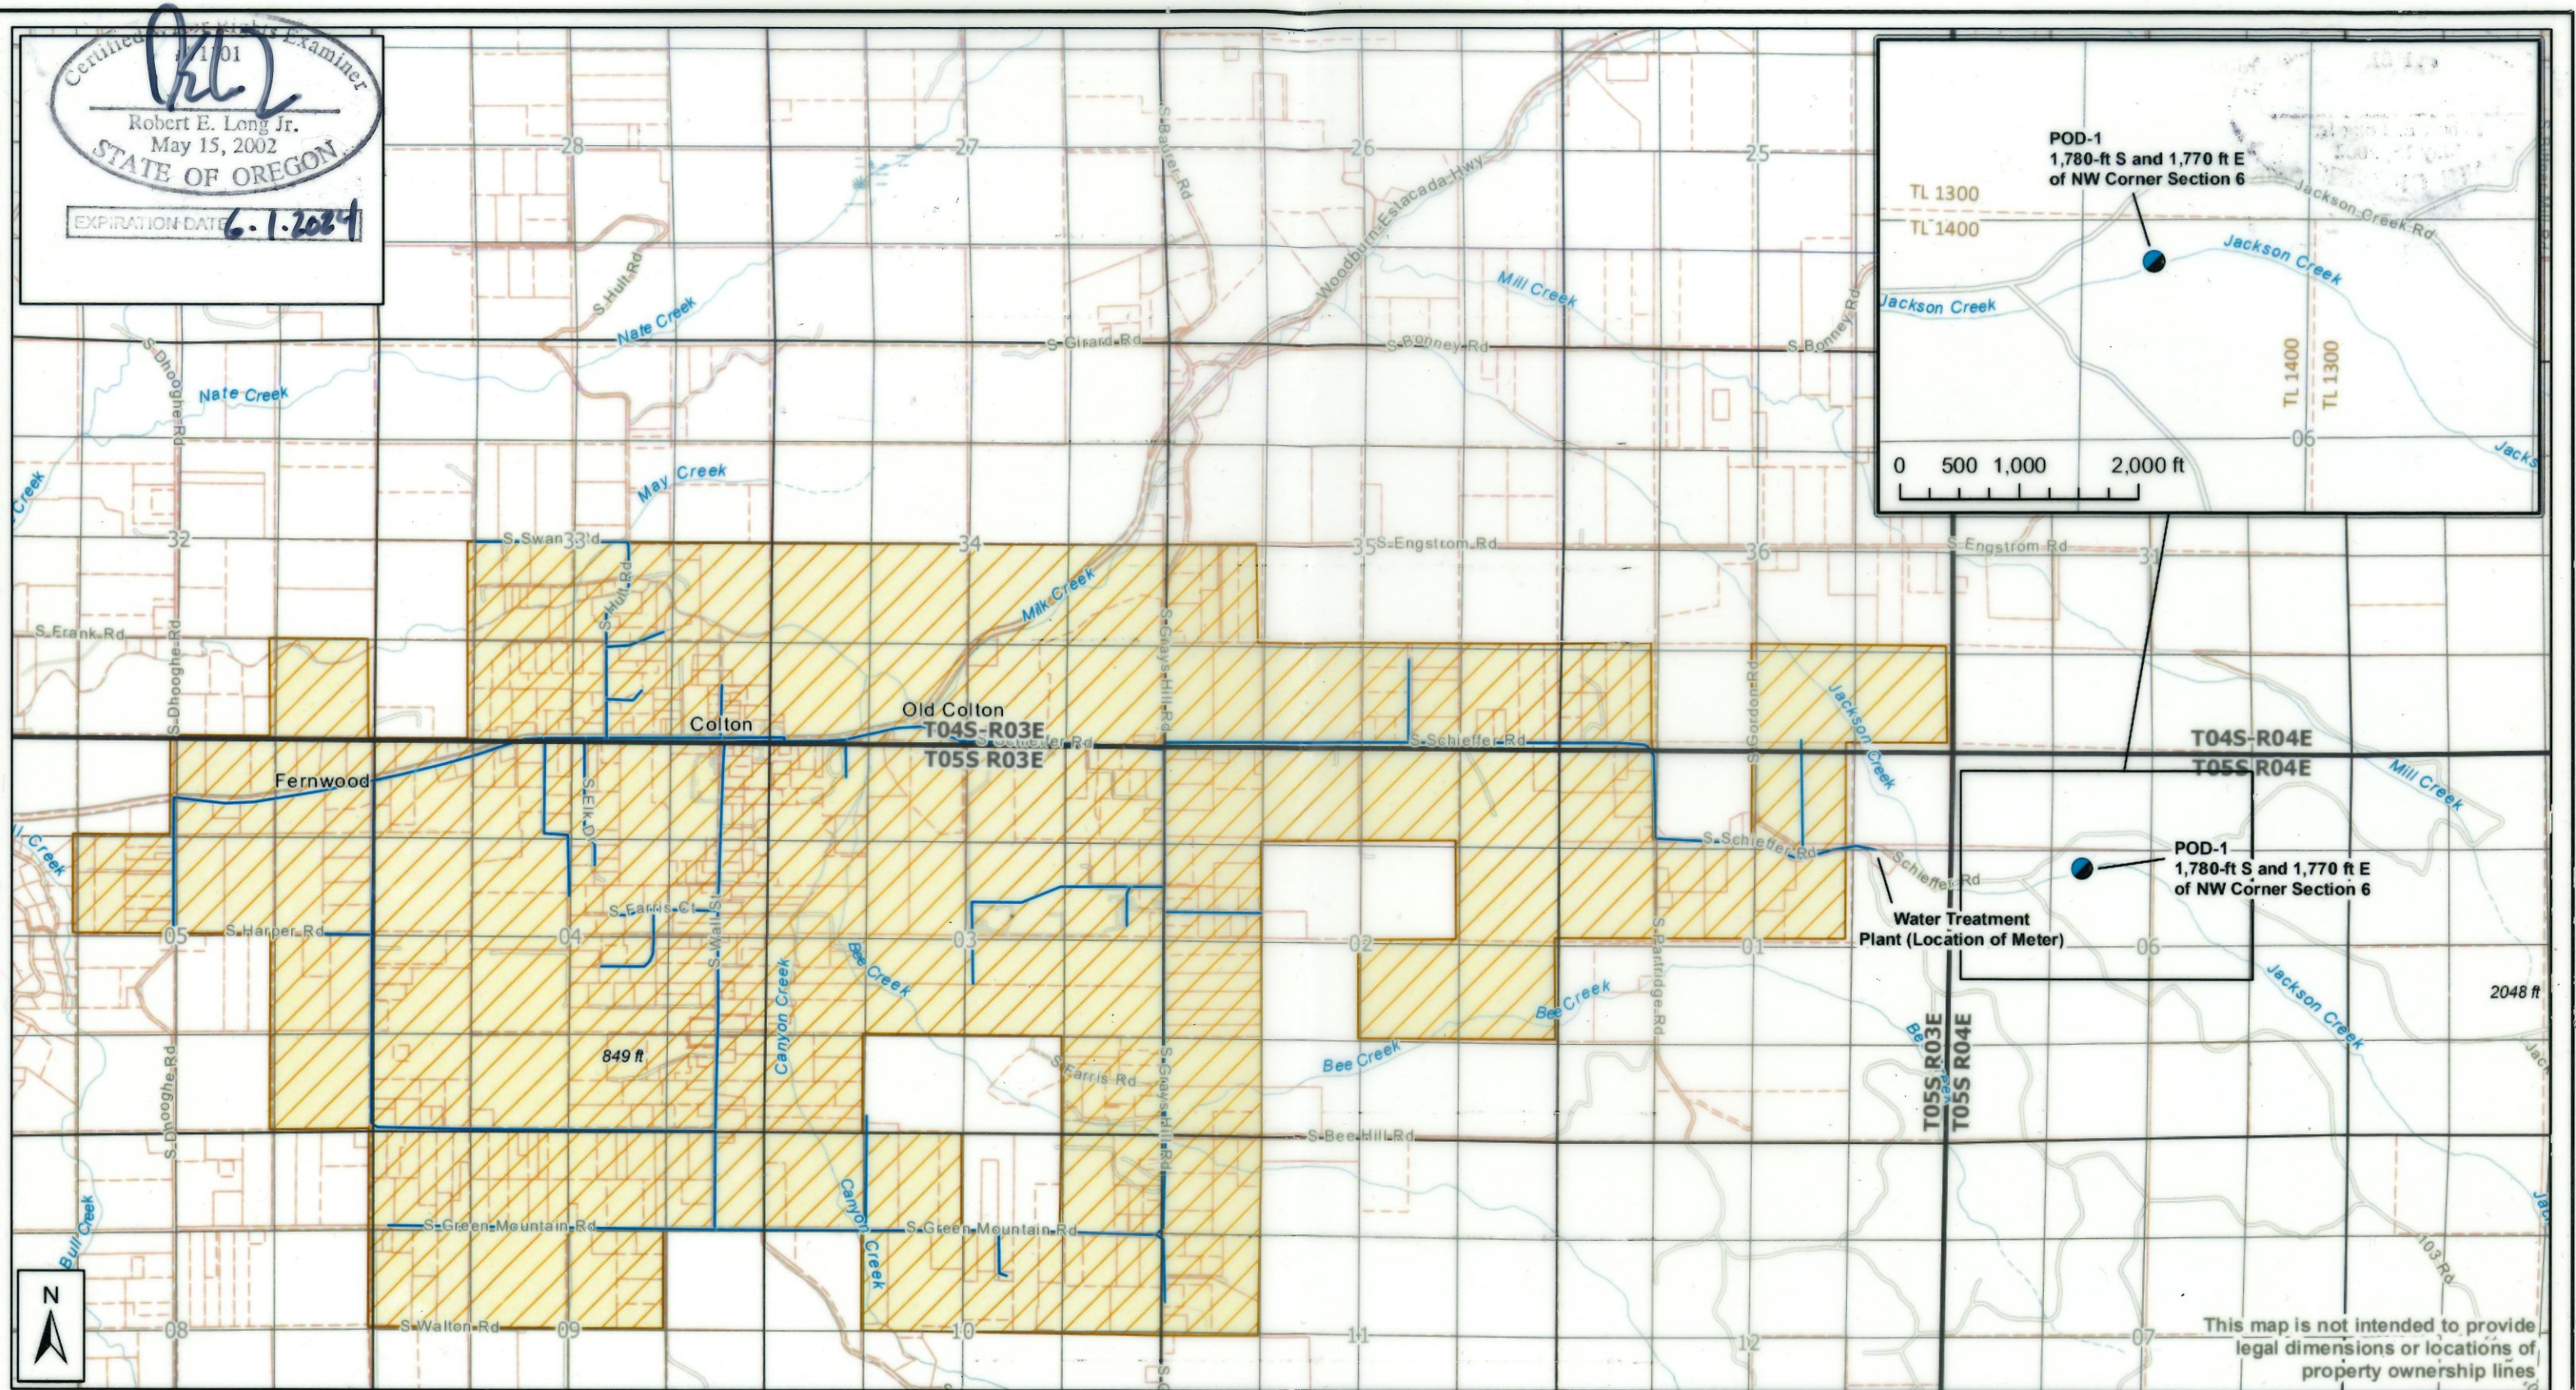

This map is not intended to provide legal dimensions or locations of property ownership lines

CWM-H2O
 Complete Water Management
 1319 SE MLK Jr. Blvd, Suite 204
 Portland, Oregon 97214
 (503) 954-1326

Colton Water District - Incremental Perfection
App S-58553, Permit S-44505
T4S, R3E Sections 32-36 / T5S, R3E Sections 1-5, 9-10

1	DATE	AUTHOR	DRAFT

Proj#: 2309001
 Colton WD CBU
 Colton Water District
 PO Box 171
 Colton, OR 97017

Scale 1 : 36,000

COBU map #2095

- Permit S-44505 POU
- Permit S-44505 POD
- Distribution System
- Taxlots

RECEIVED
 FEB 16 2024
 OWRD